


Section 14 Township 29 Range 9W
Well No. 14 Mueller "C"
Company Cities Service

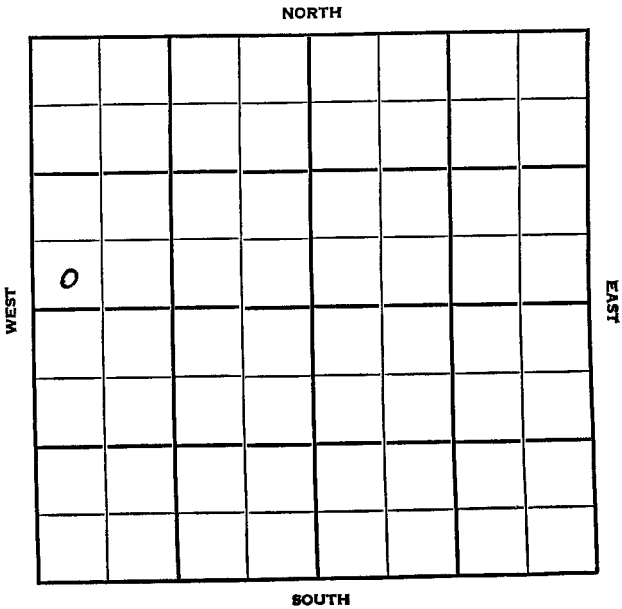

Kingman			KANSAS		
SEC.	TWP.	R.			
14	29	9W			

WELL NO.

#4 Mueller "C"

FARM

COMPANY

Gities Service

CONTRACTOR

Prime Drlg.

Willowdale Pool


NORTH

Ft. from N. Line

Ft. from S. Line

Ft. from E. Line

Ft. from W. Line

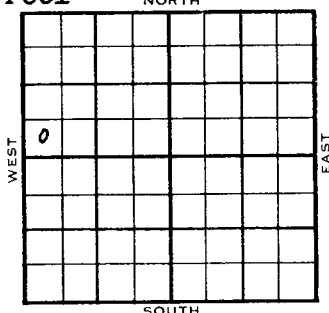

SW SW NW

	ELEVATION	REPORT
1954	1673'	
11/17	Spud 11-14-54 8" @ 307' Drlg. 1220'	
12/29	Spud 11-14-54 Oil well TD 4653' 8" @ 307 Heeb 3330 Dodge 3347 Lans 3534 Miss 4179 DST 4180-99 open 1 hr rec 216' SG & OCM, 120' OCM & SW, 62' mud & SW 1315# Viola 4471 DST 4472-76 open 1 hr rec 50' OCM 106# DST 4472-81 open 1 hr rec 153 SG & OCM, 21' mud & wtr. DST 4481-91 open 1 hr rec 134' mud 176' mud & SW 1507# Simp. 4523' Arb. 4644 TD 4653 5" @ 4653 CO to 4632 21/4470-75 500 A P/L3 BO 110 BW Comp. 312 BOPD 72 BW	
	COMPLETED	

County **Kingman** State **Kansas**Sec. **14** (Blk. Twp.) **29** (Sur. Rge.) **9W** Map No.Operator **Cities Service**Well No. **4** Farm **Mueller "C"**Elev. Location **SW ST NW**

0							

FIRST REPORT

330 Ft. From **S** Line **NW**330 Ft. From **W** Line Quarter1st. Report **NOV 17 1954**

Completion

Remarks

Prime Drlg. - Contr.Spudding Date **11-14-54**Drlg. Data **Willowdale Pool****8" @ 307 drlg. 1220**

County Kingman State Kansas
 Sec. 14 (Blk.) 29 (Sur.) 9W Map No.

Operator Cities Service
 Well No. 4 Farm Mueller "C"

Elev. 1673 Location SW SW NW

330 Ft. From S Line NW

330 Ft. From W Line Quarter

1st. Report

Completion DEC 29 1954

Remarks Willowdale Pool

Prime Drlg. - Contr.

Spudding Date 11-14-54

Drlg. Data Oil well TD 4653

8" @ 307 Heeb. 3330 Dodge 3347

Lans. 3534 Miss. 4179 DST 4180-99

open 1 hr. Rec. 216' sg & ocm 120' ocm

& sw 62' mud & sw 1315# Viola 4471

DST 4472-76 open 1 hr. Rec. 50' ocm

106# DST 4472-81 open 1 hr. Rec. 153'

sg & ocm 21' mud & wtr. DST 4481-91

open 1 hr. Rec. 134' mud 176' mud & sw

1507# Simp. 4523 Arb. 4644

TD 4653 5" @ 4653 CO to 4632

21/ 4470-75 500 A P/ 43 bo 110 bw

Comp. 312 bopd 72 bw

FABEN GILSTRAP