


Section 14 Township 29 Range 9 W

Well No. # 2 Mueller "D"

Company Cities Service

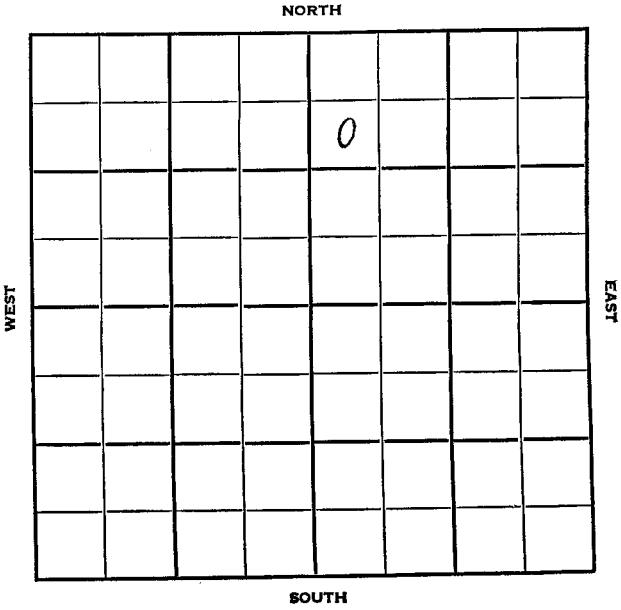

SEC. 14	TWP. 29	R. 9W
------------	------------	----------

WELL NO. #2 Mueller "D" FARM

COMPANY Cities Service

CONTRACTOR Barbour


Willowdale Pool

990 Ft. from N. Line

Ft. from S. Line

Ft. from E. Line

330 Ft. from W. Line

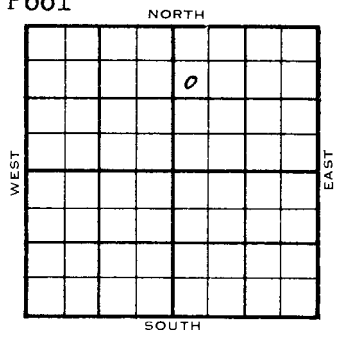

SW NW NE

1955	ELEVATION	REPORT
------	-----------	--------

3/16	Spud 3-12-55 8" @ 325' Drlg. 1710'
------	--

