


Section 14 Township 29 Range 9W
Well No. 1 Mueller "D"
Company Cities Service

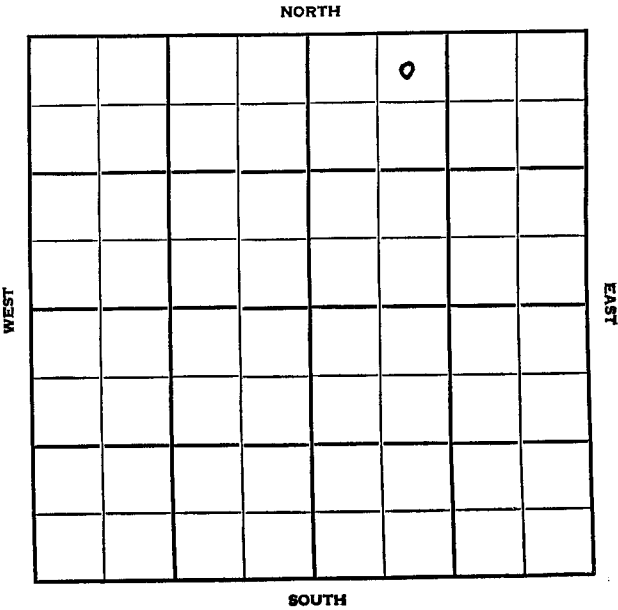

Kingman

KANSAS

SEC.	TWP.	R.
14	29	9W

WELL NO.

#1 Mueller "D"

FARM

COMPANY

Cities Service

CONTRACTOR

Barbour

Willowdale Pool

NORTH

330


Ft. from N. Line

Ft. from S. Line

Ft. from E. Line

990

Ft. from W. Line

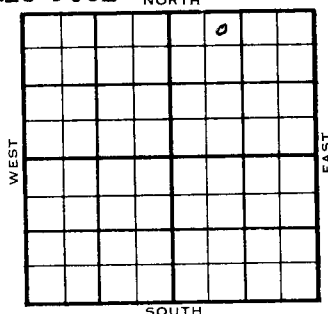

NE NW NE

1954

ELEVATION

1704'

REPORT

10/27

Location

12/8

Spud 10-28-54 - Oil Well

TD 4523'

8" @ 312'

Doug. 3378'

DST 3383-3410', opn 1 hr., rec. 330'

SW, 1040#

KC 3558', Miss 4214'

DST 4215-35', opn 1 hr., rec. 35' mud, 170#

Kh. 4320', Viola 4493'

DST 4494-99', opn 1 hr., gas in 6",

F/oil in 50", 21 boph 1500#

TD 4523'

5" @ 4523'

CO to 4509'


16/4491-95, S/30 bo 15 hrs., 250A

F/8½ boph 8 hrs.

F/200 bo 24 hrs.

Comp. F/238 boph

COMPLETED

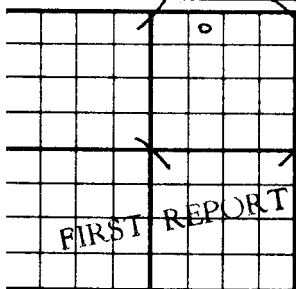County Kingman State KansasSec. 14 (Blk.) 29 (Sur.) 9W Map No.Operator Cities ServiceWell No. 1 Farm Mueller "D"Elev. Location NE NW NE330 Ft. From N Line NE990 Ft. From W Line Quarter1st. Report OCT 27 1944

Completion

Remarks

Barbour - Contr.

Spudding Date

Orig. Data Willowdale PoolLocation



County Kingman State Kansas
 Sec. 14 (Blk. 29 (Sur. 9W Map No.)
 Twp.) Rge.)

Operator Cities Service

Well No. 1 Farm Mueller "D"

Elev. 1704 Location NE NW NE

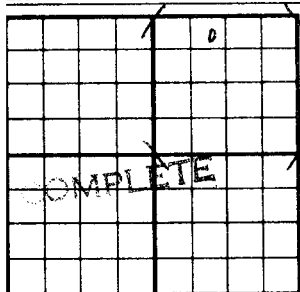

330 Ft. From N Line NE

990 Ft. From W Line Quarter

1st. Report

Completion DEC 1957

Remarks Willowdale Pool

Barbour - Contr.

Spudding Date 10-28-54

Drlg. Data Oil well TD 4523

8" @ 312 Doug. 3378 DST 3383-3410

open 1 hr. Rec. 330' sw 1040#

KC 3558 Miss. 4214 DST 4215-35

open 1 hr. Rec. 35' mud 170#

Kh. 4320 Viola 4493 DST 4494-99

open 1 hr. gas in 6 min. F/ oil in

50 min. 21 boph 1500# TD 4523

5" @ 4523 CO to 4509 16/ 4491-95

S/ 30 bo 15 hr. 250 A F/ 8 1/2 boph

8 hr. F/ 200 bo 24 hr.

Comp. F/ 238 bopd

FACE OF STRAP