


SECTION 14 TOWNSHIP 29 RANGE 2W

WELL NO. #1 Burchell

COMPANY E.H. Adair

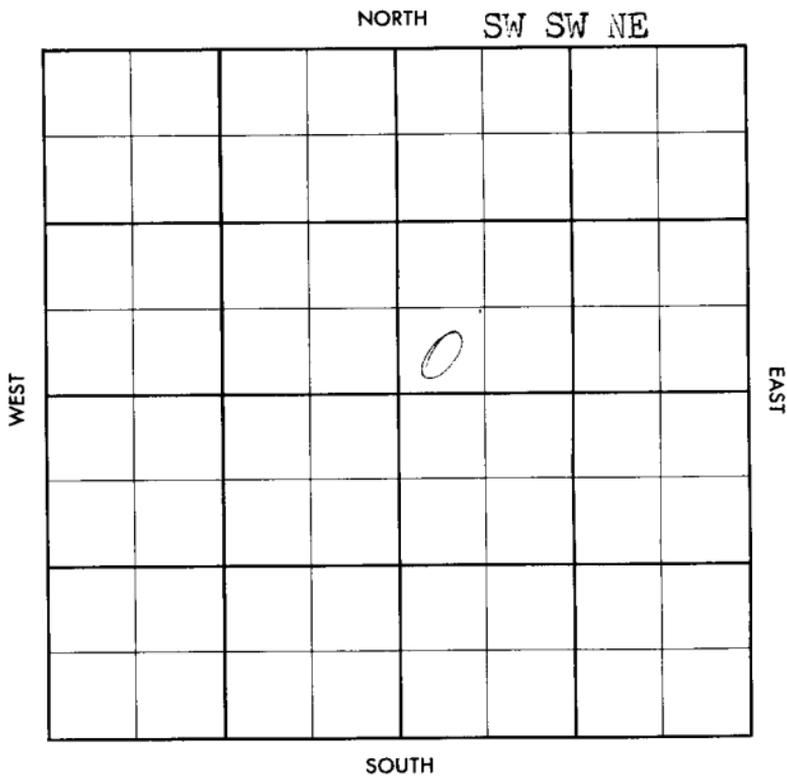

WILDCAT

County Sedwick Elev. _____
 Sec. 14 Twp. 29 Rge. 2W
 Company B. N. Adair
 Farm Name Burrell No. 1

TOPS	DEPTH	LOG	DATUM
Anh.			
TP.			
H.			
Tr.			
Dg.			
Bl.			
L.			
K.C.			
B.K.C.			
Ce.			
C.			
M.			
M.			
K.			
Mz.			
Mo.			
V.			
S.			
S.			
A.			
R.			
PE.			
G.			
TD.			

Loc. in Sec. SW SW NE

Geol. _____
 Cont. _____
 Co. tools _____
 Prod. _____
 Wildcat _____

FIRST REPORT
 2
 MAY 1 1957

Date Comm. 4-27-57
 8" @ 398/275 drlg. 900

28

Co.

Loc.

No.

Sec.

T.

R.


	TOPS	DEPTH	LOG	DATUM
Anh.				
Top.				
H.				
Tr.				
Dg.				
Bl.				
L.				
K.C.		2952		
B.K.C.		3149		
Ce.				
C.				
M.		3570		
M.				
K.		3920		
Mz. <u>sd</u>		3982		
Mo.				
V.				
S.		3989		
A.				
R.				
PE.				
G.				
TD		3998		


Geol. _____
 Contr. _____
 Co. tools _____
 Prod. _____
 Test _____

ABANDONED
 MAY 15 '57


@ 2975 +st wt. @ 3300
 MAY 15 '57 DST 2965-27 of 1hr
 10' SSE GCM + 30' 175W BHP
 275/20"

DEA