
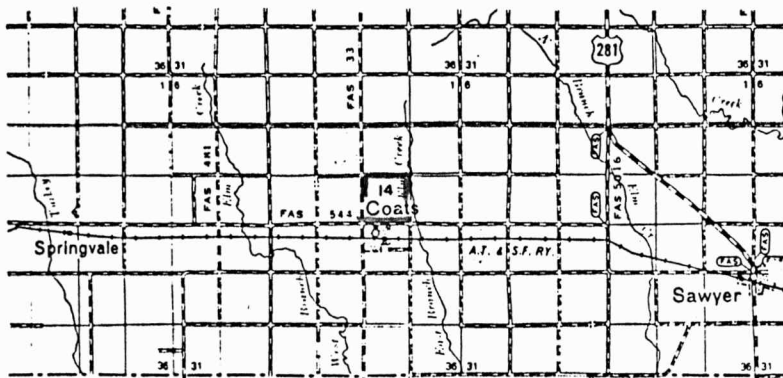


14-295-14W

AGATE PETROLEUM INC.
LUTHER LEASE
NW 1/4, SECTION 14, T29S, R14W
PRATT COUNTY, KANSAS

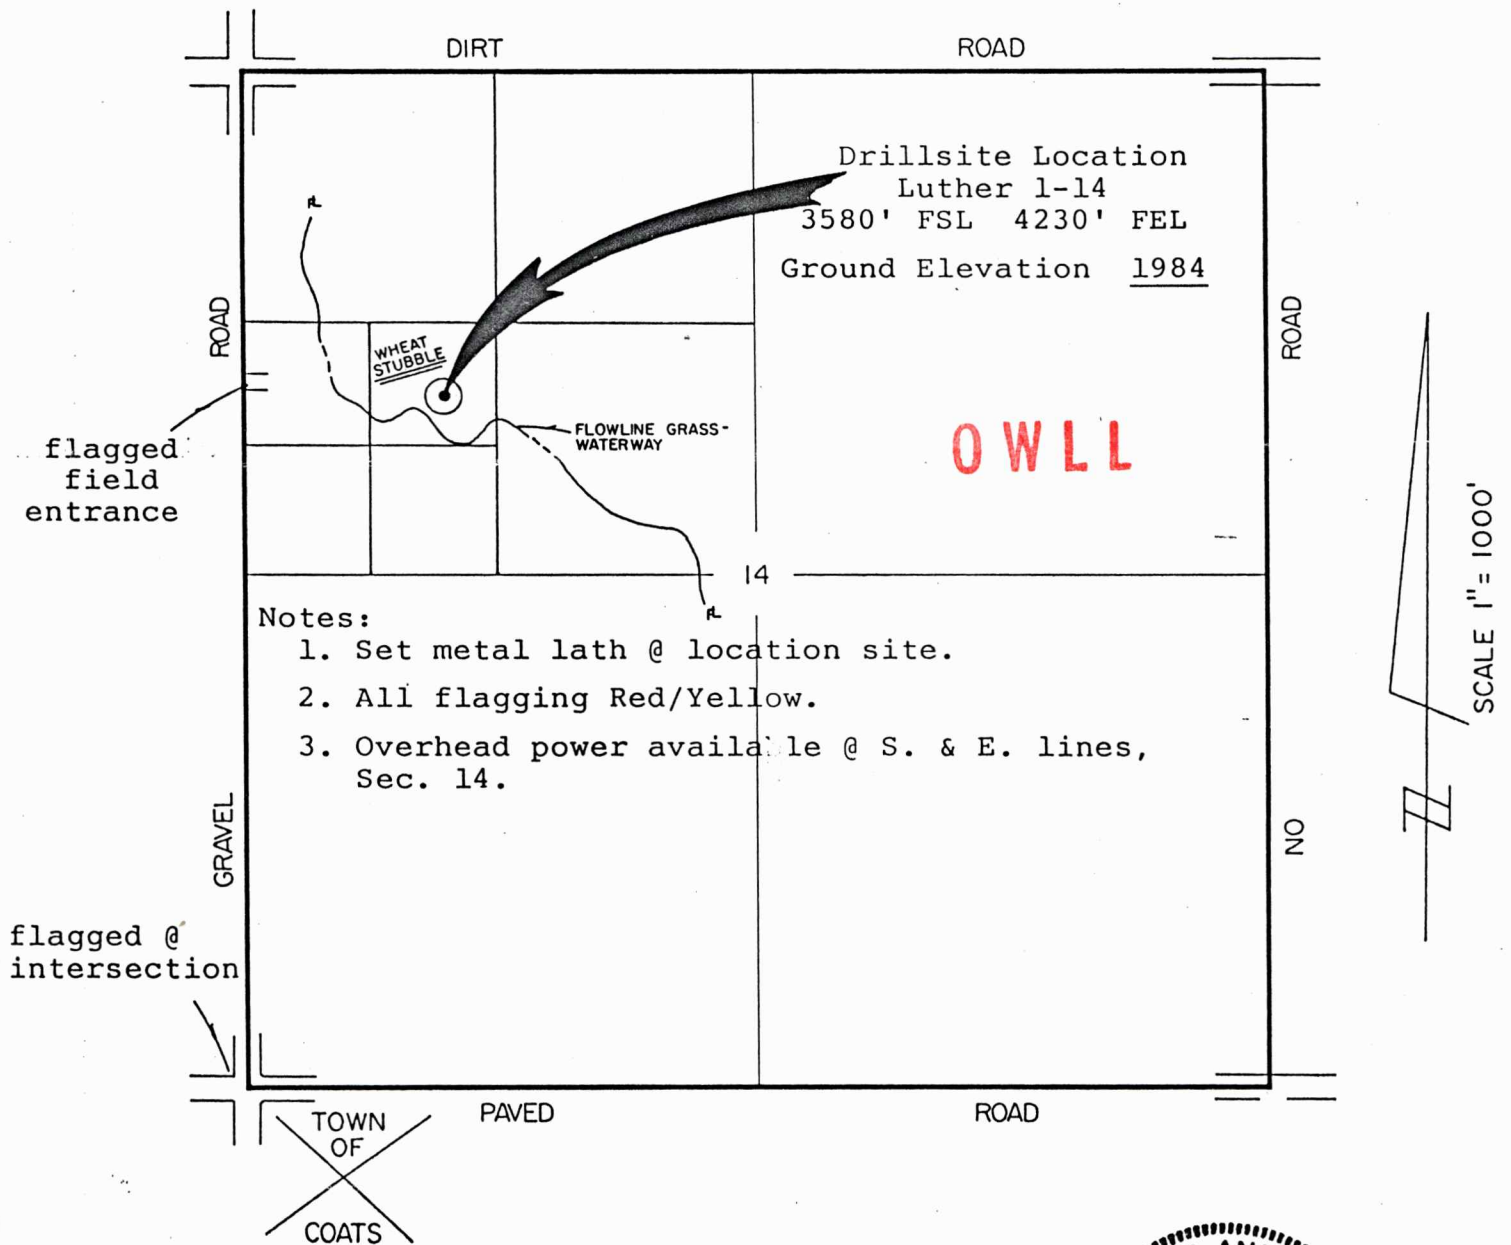

*Controlling data is based upon the best maps and photographs available to us and upon a regular section of land containing 640 acres.

*Aerial Photographs available at the U.S. A.S.C.S. Office located at the County Seat.

*Elevations derived from National Geodetic Vertical Datum.

Randy E. Anderson

Randy E. Anderson, R.L.S. 802

Date June 16, 1987

