


Section 15 Township 29 Range 9W
Well No. 1 Hagerman (*Hagerman*)
Company Aylward Drlg.

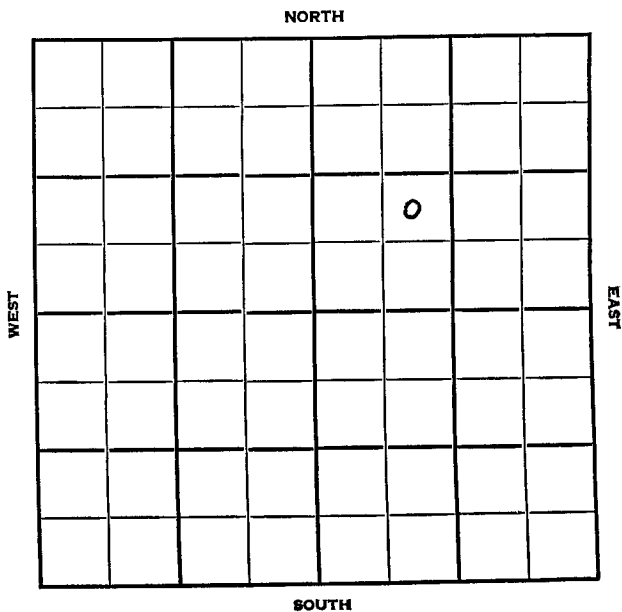

Kingman

KANSAS

SEC.	TWP.	R.
15	29	9W

WELL NO.

#1 Hagerman

FARM

COMPANY

Aylward Drlg.

CONTRACTOR

Willowdale Pool

NORTH

Ft. from N. Line

990


Ft. from S. Line

Ft. from E. Line

990

Ft. from W. Line

NE SW NE

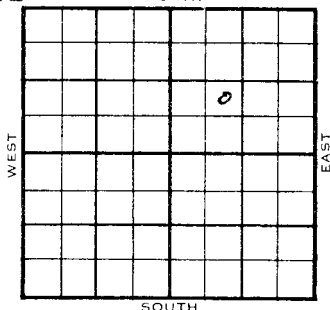

	ELEVATION	REPORT
1954	1700'	

1/23


C & P

1955

1/26

Spud 11-26-54 Oil well TD 4536
 8" @ 137 Miss. 4199 Viola 4502
 DST 4503-08 open $\frac{1}{2}$ hr rec 810' oil
 30 min. 120' wtr. 1500#
 TD 4536' 5" @ 4535 CO to 4526
 2/4501-02 3/4502-05 24/4501-06
 FU 3000' oil 450' wtr.
 Comp. 39 BOPD 60% wtr.

COMPLETED

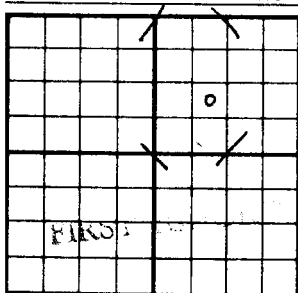County **Kingman** State **Kansas**Sec. **15** (Blk. **29** (Sur. **9W** Map No.Operator **Aylward Drlg.**Well No. **1** Farm **Hagerman**Elev. Location **NE SW NE**990 Ft. From **S** Line **NE**990 Ft. From **W** Line Quarter1st. Report **NOV 23 1954**

Completion

Remarks


Spudding Date

Willowdale Pool

Drlg. Data

Cellar & pits

FARM ON STR

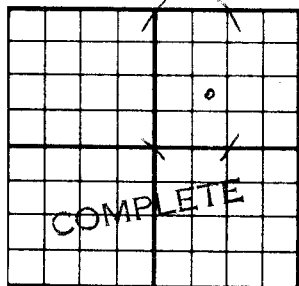County Kingman State KansasSec. 15 (Blk.
Twp.) 29 (Sur.
Rge.) 9W Map No.Operator Aylward Drlg.Well No. 1 Farm HagermanElev. 1700 Location NE SW NE990 Ft. From S Line NE990 Ft. From W Line Quarter1st. ReportCompletion JAN 26 1955Remarks Willowdale PoolSpudding Date 11-26-54Drlg. Data Oil well TD 45368" @ 137 Miss. 4199 Viola 4502DST 4503-08 open $\frac{1}{2}$ hr. Rec. 810' oil30 min. 120' wtr. 1500# TD 45365" @ 4535 CO to 4526 2/ 4501-023/ 4502-05 24/ 4501-06 FU 3000' oil450' wtr. Comp. 39 bopd 60% wtr.

FABEN GILSTRAP