

Kingman

KANSAS

15

29

9W

SECTION _____ TOWNSHIP _____ RANGE _____

WELL NO. #1 HogemanCOMPANY Anschutz Drlg.

NORTH

0							

WEST

EAST

SOUTH

Kingman

KANSAS

SEC.	TWP.	R.
15	29	9W

WELL NO.

#1 Hogeman

FARM

COMPANY

Anschutz Drlg.

CONTRACTOR

Co. Tools

Willowdale


Ft. from N. Line

Ft. from S. Line

Ft. from E. Line

Ft. from W. Line

SW NW NW

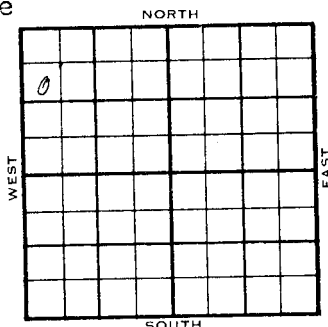

Magnolia- FO

	ELEVATION	REPORT
1956	1673'	
4-25	MIR	
5-2	Comm. 4-26-56	
	8 5/8" @204 w/150	
5-9	DST 3339-3445, open 1 hr, rec 1000'	
	MSW	
	BHP 1050#	
	DST 4182-87, open 1 hr, rec 60' gc & socm / 1260' gc & wcm	
	No pressure, rec	
	DST 4182-92, open 1 hr, rec 45' hgc & socm / 135' gc & wcm / 15' sw	
	BHP 1455/ 20"	
5-16	DST 4485-89, open 1 hr, g in 7 1/2", rec 3350 fluid (120' gcm & sgom / 370' o & gcm, 10% wtr, 1300' gco, 30% wtr, 680' sgco, 10% wtr, 120' sgc 50% wtr, 580' gcm / 150' sw)	
	BHP 1420/ 20"	
	5 1/2" @4524 w/100	
	8/ 4483-85	
	FU 850' fluid in 15", 1200' in 30"	
5-23	Swabbed 29 boph / 60% wtr. / 5 hrs. 1500' O. B.; T & R	
5-29	No report	
8-6	P/ 38 bo / 45 bw / 24 hrs. WOPT	

OVER

1956

6-13

6-20

No report

P/ 64 bopd / 57% wtr.

H. 3339', Tr. 3368', Dg. 3381',

L. 3557', B.K.C. 3989', M. 4180',

K. 4293', V. 4483',

TD 4525'

COMPLETED

~~County~~ **Kingman** ~~Elev.~~
~~Sec.~~ **15** ~~Twp.~~ **29** ~~Rge.~~ **9W**
~~Farm Name~~ **Hogeman** ~~No.~~ **1**

TOPS	DEPTH	LOG	DATUM	Loc. in Sec.
Anh.				SW NW NW
Tp.				
H.				
Tr.				
Dg.				
Bl.				
L.				
K.C.				Geol.
B.K.C.				Contr.
Ce.				Co. tools
C.				
M.				
M.				
K.				Pool
Mz.				Willowdale
Ma.				
V.				
S.				
S.				
A.				
R.				
Pe.				
G.				
TD.				

10

20

30

40

50

60

70

80

90

100

FIRST REPORT

APR 25 '56

Date Comm. **M I R** **Magnolia - FO**

27

County Kingman Elev. 1675
 Sec. 15 Twp. 29 Rge. 9W
 Company Anschutz Drlg.
 Farm Name Hogeman No. 1

TOPS	DEPTH	LOG	DATUM	Loc. in Sec.
Anh.				SW NW NW
Tp.				
H.	3339			
Tr.	3368			
Dg.	3387			
Bl.				
L.	3557			
K.C.				Geol.
B.K.C.	3989			Contr.
Ce.				Co. tools
C.				Pool
M.	4180			Willowdale
M.				
K.	4293			
Ma.				
Ma.				
V.	4483			
S.				
S.				
A.				
R.				
Pe.				
G.				
Td.	4525			

COMPLETE

JUN 2 0 1956

Date Comm. Magnolia - FO

M I R MAY 2 '56 4-26-56 85/8

204/150 DST 3779-3445

MAY 9 '56

1 hr rec 1000' MSW BHP

1050 DST 4182-87 1 hr rec 60'

GC & 50 CM + 1260' GC & WCM no

press rec. DST 4182-92 1 hr

rec. 45' HGC & 50 CM + 135' GC &

WCM + 15' SW BHP 1455/20" ID

4266 MAY 18 '56 DST 4485-89 1 hr

SW WIND

7 1/2" ~~WATER~~ ~~WATER~~ ~~WATER~~
 3350 Fluid (120' OCM &
 500M + 370' OCM 50% WT
 1300' OCM 30% WT 680' SGC
 50% WT 120' SGC 50% WT
 500' OCM + 150' SW BHP 1420/20
 5 1/2" 4524/100 8/4483-85
 BU 850' Fluid in 15" 1300'
 in 30" MAY 23 '56 29 Depth
 50% WT 5' SW 1500' O.B.
 T & R MAY 29 '56 JUN 6 '56
 P 38 BO + 45 BW / 24 WPT
 JUN 20 '56 Ph R. 64 Bopd
 + 57% WT