


Section 15 Township 29 Range 9W
Well No. 2 Hageman
Company ☒ Cities Service

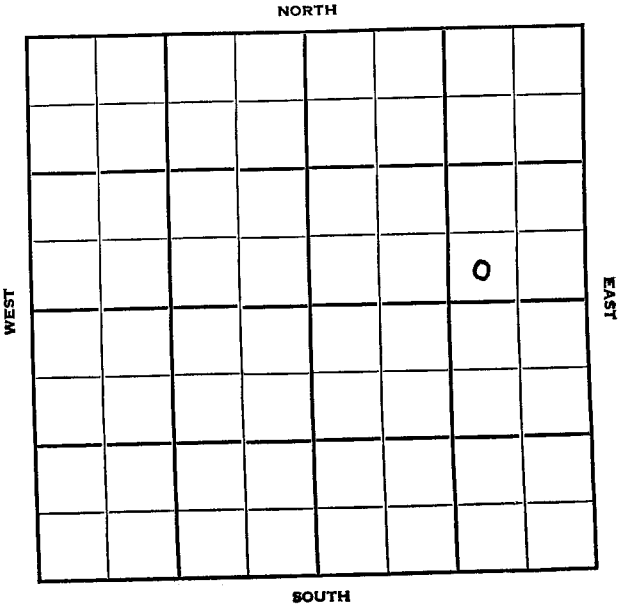

Kingman KANSAS

SEC.	TWP.	R.
15	29	9W

WELL NO.

2 Hageman FARM

Cities Service

CONTRACTOR


Prime Drlg.
Willowdale Pool

Ft. from N. Line

330 Ft. from S. Line

990 Ft. from E. Line

Ft. from W. Line

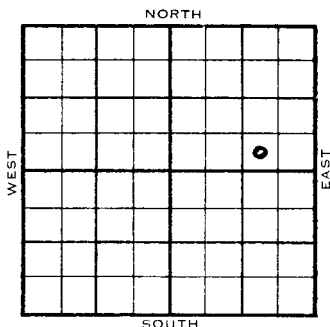

SW SE NE

ELEVATION	REPORT
1954	1690'


9/1 Spud 8-26-54
8" @ 346'
Drlg. 2575'

10/20 Spud 8-26-54
Oil Well
TD 4510'
8" @ 346'
Heeb 3334', Dodge 3351', Doug 3365'
Lans 3542', Miss 4195',
DST 4192'-4211' opn 1 hr, rec 160' gc,
& smco, 60' g & ocm, 1080# Viola 4481'
DST 4482'-86' opn 1 hr, gas in 10 min
rec 2120' oil, 350' mco, 30' ocm & wtr
1560#
TD 4510'
5" @ 4510'
CO to 4505'
20/ 4482-87 FU 1945' oil 50 min
7/ 71 bo 6 bw 6 hr. P/ 113 bo 7 bw
12hr.
P/ 126 bo 18 bw 24 hr.
Comp 175 bopd. 26 bw.

COMPLETED

OPEN C. 22

County Kingman State Kansas
 Sec. 15 (Bk.) 29 (Sur.) 9W Map No.
 Operator Cities Service
 Well No. 2 Farm Hageman
 Elev. 1690 Location SW SE NE

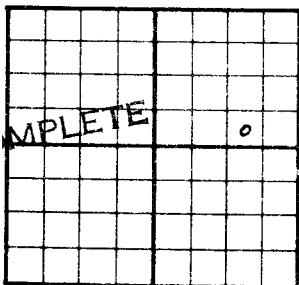

330 Ft. From S Line NE
990 Ft. From E Line Quarter

1st. Report

Completion OCT 20 1954

Remarks Willowdale Pool

Prime Drlg. - Contr.

Spudding Date 8-26-54

Drlg. Data Oil well TD 4510

8" @ 346 Heeb. 3334 Dodge 3351

Doug. 3365 Lans. 3542 Miss. 4195

DST 4192-4211 open 1 hr. Rec. 160' gc

& smco 60' g & ocm 1080' Viola 4481

DST 4482-86 open 1 hr. gas in 10 min.

Rec. 2120' oil 350' mco 30' ocm & wtr.

1560' TD 4510 5" @ 4510 CO to 4505

20/ 4482-87 FU 1945' oil 50 min.

S/ 71 bo 6 bw 6 hr. P/ 113 bo 7 bw

12 hr. P/ 126 bo 18 bw 24 hr.

Comp. 175 bopd 26 bw

PAID BY STRAD