


DX 78-1

Kingman KANS S

Section 15 Township 29 Range 9W
Well No. 3 Hageman
Company Cities Service

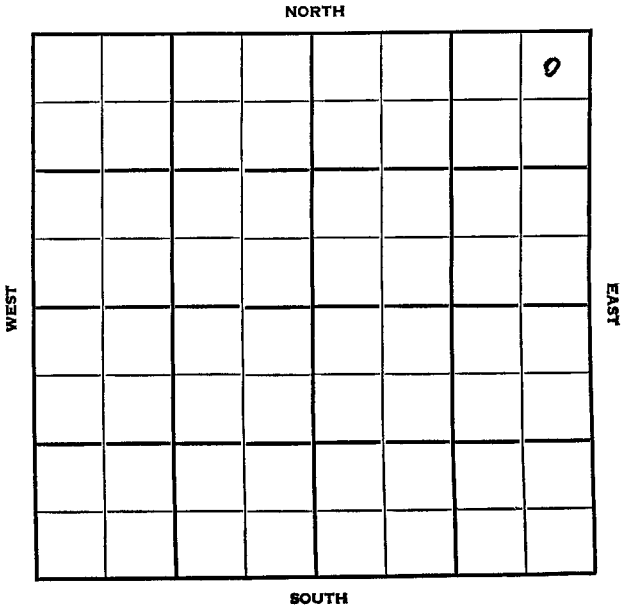

SEC.	TWP.	R.
15	29	9W

WELL NO.

#3 Hageman

FARM

COMPANY

Cities Service

CONTRACTOR

Prime Drlg.

Willowdale Pool NORTH

330

Ft. from N. Line

							0

Ft. from S. Line

330

Ft. from E. Line

Ft. from W. Line

NE NE NE

SOUTH

	ELEVATION	REPORT
1954	1702'	

10/27 Location

12/8

Spud 10-27-54 - Oil Well

TD 4513'

8" @ 313'

KC 3554', Miss 4196'

DST 4197-4215', opn 1 hr., gas in 14"
rec. 170' gcm, 1410#

Kh. 4304', Viola 4483'

DST 4484-88', opn 1 hr., rec. 97' G&O
M, 1575#DST 4488-93', opn 1 hr., gas in 10",
rec. 1575' oil, 1485#

TD 4513'

5" @ 4513'

CO to 4499'

24/4483-89, 8/4489-91

P/103 bo 24 hrs.

P/4 bopd

Comp. 115 bopd

COMPLETED

