


Kingman

KANSAS

SECTION 15 TOWNSHIP 29 RANGE 9W
WELL NO. #4 Hagerman (Hagerman)
COMPANY Anschutz Drlg.

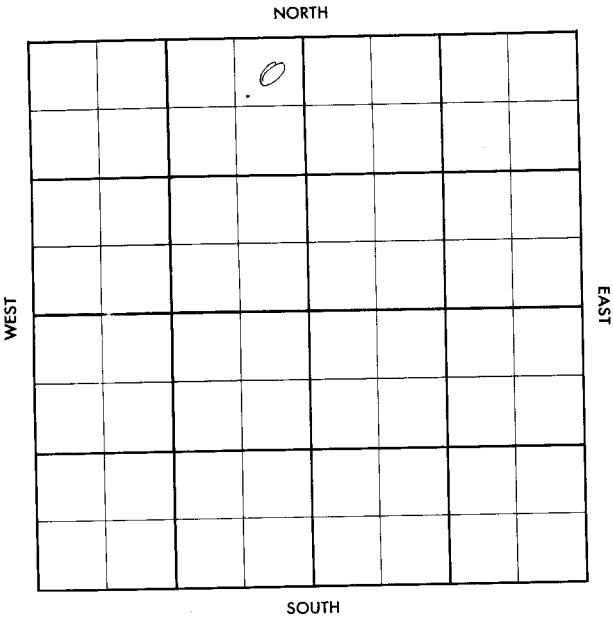

ORM 513 SUNRAY

County Kingman Elev. _____
 Sec. 15 Twp. 29 Rge. 9W
 Company Anshutz Drlg.
 Farm Name Hagerman No. 4

TOPS	DEPTH	LOG	DATUM	Loc. in Sec. _____
Anb.				NE NE NW
Tr.				
H.				
Tr.				
Dg.				
Bl.				
L.				Geol. _____
K.C.				Contr. _____
B.K.C.				Co. Tools _____
Ce.				Pool _____
C.				Willowdale
M.				
M.				
K.				
Mz.				
Me.				
V.				
S.				
S.				
A.				
R.				
Pe.				
G.				
TD.				

FIRST REPORT
 DEC 28 1966

Date Comm. MIRT

27

County Kingman Elev. 1681
 Sec. 15 Twp. 29 Rge. 9W
 Company Arshutz Drig.
 Farm Name Hagerman No. h

TOPS	DEPTH	LOG	DATUM	Loc. in Sec.
Anh.				NE NE NW
TP.				
H.	3349			
Tr.	3368			
Dg.	3378			
Bl. <u>1193d</u>	3422			
L.	3557			
K.C.				Geol.
BNC.	3992			Contr.
Ce.				
C.				Co. Tools
M.	4190			
M.				Pool
K.	4301			Willowdale
M.				
Mo.				
V.	4490			
S.				
S.				
A.				
R.				
Pe.				
G.				
TD	4493			

ABANDONED
 JAN 16 57

Date Comm.

MIAT JAN 2 '57 12-26-56 878 209
 Ø 3590 JAN 6 '57 DST 4192-98
 1hr G 10" 9a 260 MCF/16 9a.
 230 MCF/1hr rec 90' G 8 HOCM
 BHP 1450 DST 4198-4206 1hr
 120 G 1R rec 35' GCM (550)
 + 30' MSW BHP 1165 Ø 4255
 JAN 10 '57 DST 4488-93 1hr 1100 086CSW
 1320/20 D&Q