


Section 15 Township 29 Range 9 W

Well No. # 4 Hageman

Company Cities Service

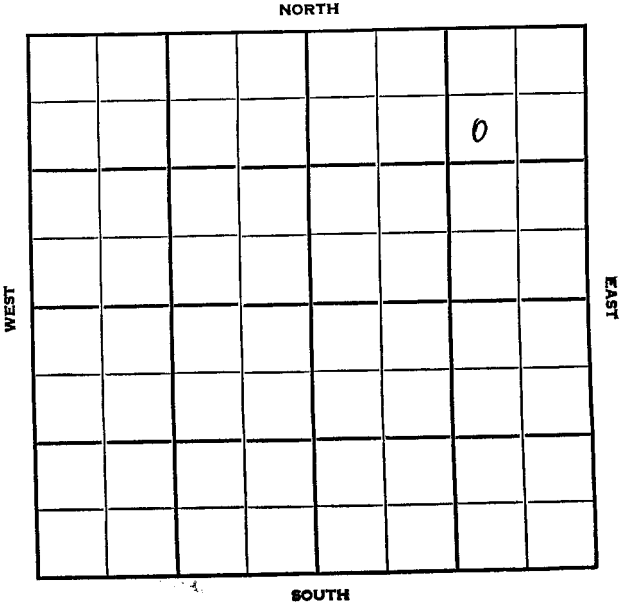

Kingman

KANSAS

SEC.	TWP.	R.
15	29	9W

WELL NO. #4 Hageman FARM

COMPANY Cities Service.

CONTRACTOR Barbour.

Willowdale Pool

990 Ft. from N. Line

990 Ft. from S. Line

990 Ft. from E. Line

Ft. from W. Line

SW NE NE

	ELEVATION	REPORT
1954	1702'	

12/29 Spud 12-23-54
8" @ 332'
Drlg. 1920'

1955
2/9 Spud 12-23-54 Oil well TD 4525'
8" @ 332' neeb 3340 Dodge 3356
Doug 3371 Lans 3554 Miss 4199
DST 4200-19 open 1 hr gas in 2 1/2 min
458,000 CFG, rec 188' G & OCM & W
92' OCSW 1400# Kh. 4312', Viola 449
DST 4496-4503, open 1 hr rec 31' OCM
171' MCO, 10' SW 1545#. TD 4525'
5" @ 4525' CO to 4509 13/4495-98
FU 850' oil 18 hr. 250 A
F/20 BO 2 hr. F/96 BO 1 BW 24 hr.
Comp. F/282 BOPD 2% wtr.

COMPLETED

