


SECTION 15 TOWNSHIP 29S RANGE 7WWELL NO. #1-VoranCOMPANY W. J. Coppinger

C SW SE

NORTH

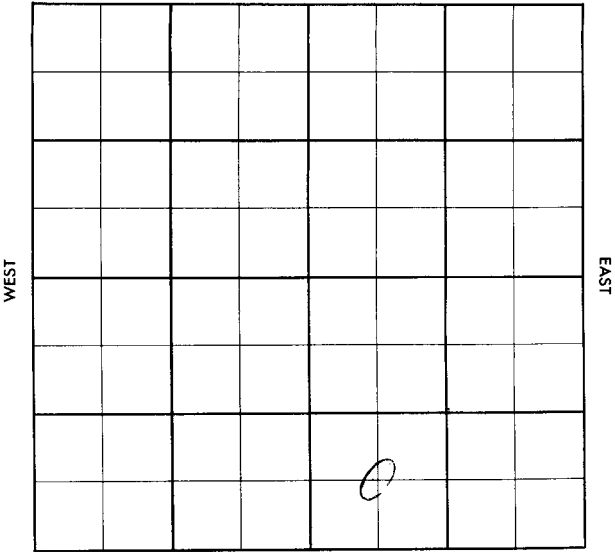

SOUTH

Kingman

KANSAS

SEC.

TWP.

R.

15

29 S

7 W

WELL NO.

1 Voran

FARM

COMPANY

W. J. Coppinger

CONTRACTOR

D & M Drlg.

Voran


____ FT. FROM N. LINE

____ FT. FROM S. LINE

____ FT. FROM E. LINE

____ FT. FROM W. LINE

C SW SE

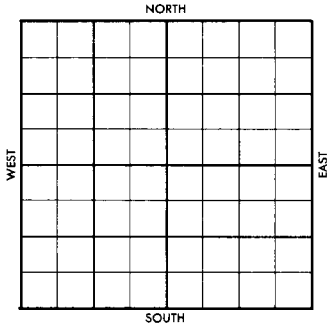

SDX-3/4 Mile CSO -FO

1957

ELEVATION

REPORT

7/17

Comm. 7-12-57
 8" @ 265/200
 Drlg. 1697'

(FR Tkt)

ORM 513 SUNRAY

County Kingman Elev. _____
 Sec. 15 Twp. 29 Rge. 7W
 Company M. J. Coppinger
 Farm Name Voran No. 1

TOPS	DEPTH	LOG	DATUM	Loc. in Sec. _____
Anb.				<u>0 SW SE</u>
T.P.				
H.				
Tr.				
Dg.				
BL.				
L.				Geol. _____
K.C.				Contr. _____
B.K.C.				<u>D & M Drlg.</u>
Ce.				Pool _____
C.				<u>Voran</u>
M.				FIRST REPORT <u>3 1/4 mile</u> <u>14 JUL 17 51</u> <u>SDX</u>
M.				
K.				
Mz.				
Me.				
V.				
S.				
S.				
A.				
R.				
Pe.				
G.				
TD.				

ate Comm. 7-22-57 CSO - FO
 8" • 265/200 drlg. 1697

27

27
O.W.W.O.

Trenton

S-513-B

County Kingman Elev 1602DF
 Sec. 15 Twp. 29 Rge. 7W
 Company W. J. Coppinger
 Farm Name Whitelaw No. 1

TOPS	DEPTH	LOG	DATUM
Anh.			
Tp.			
H.			
Tr.			
Dg.			
B.L.			
L.	3348		
K.C.			
B.K.C.			
Ce.			
C.			
M.	4149		
Kind.	4407		
K.			
Mz.			
Mq.			
V.	4516		
S.			
S.			
A.			
R.			
Pf.			
G.			
T.D.	4525		

Loc. in Sec.

C SW SE

(O.W.W.O.)

O.W.W.O.

Geol.

Contr.

Pool

COMPLETE
FIRST REPORT
FEB 19 58

Date Comm.

OLD INFO: (Was Voran) Arb Well POP Lang

3348, tops. 59 @ 4233 26/ 4170-75

59/ 4156-64 1250A PF/ 6 bo 35 bw 2 1/2 hr.

NEW INFO: Comp. 31 tops 18 bw

PF - 4156 4175

County Kirman Elev. 1602
 Sec. 15 Twp. 29 Rge. 7N
 Company W. J. Coppinger
 Farm Name Voran No. 1

TOPS	DEPTH	LOG	DATUM	Loc. in Sec.
Ank				0 S 1/2
Tr.				
H.	3713			
Tr.	3729			
Dg.				
Bl.				
L.	3348			Geol.
K.C.				Contr.
B.K.C.	3845			D & H Drile.
Ce.				
C.				
M. <u>Main</u>	3881			Pool <u>TRENTON</u>
M.	4149			Voran
K.				
M.				
Ma.				
V.	4519			
S.				
S.				
A.				
R.				
Pe.				
G.				
TD	4525			

Date Comm. 7-12-57

CSC - 50

8" G 265/200 drile. 1697 JUL 24 57

DST 3764-81 1hr 60' 50' SW BHP
1310 @ ahead JUL 31 57 DST 3800
-20 1hr rec 25' 50' CM +180' SW
FP 40-122 BHP 1505/15" DST
4156-80 1hr G 13" ga 648 MCF
rec 70' GCM 1 BHP 1195. FBHP
1560/20" FP 135-85 NOV 8 57 5 1/2
@ 4233/100 CA 20/4170-75 24/

3 NOV 20 57
 4 miles
 ABANDONED

4156-64 est ga 800 MCF
 Frac & Flow 10 BOPh AUG 14 57

+ ga 4.800 MCF + 1 B dist.

+ 6 BOPh + 3 + 9. AUG 21 57 AUG 28 57

SEP 4 57 ~~604205~~ S Q D SEP 11 57

SEP 18 57 SEP 25 57 OCT 2 57

C 04194 PB 4185

2250 A Fl 11 B 0 + 47 BW

15/60" Chk no tim

F 10 18 B 0 + 4 B N 24 hrs

~~B 10~~ OCT 9 57 P 100 B W pd +

Sum oil OCT 13 57 ~~1000~~

P 12 B 0 + 35 B W pd

NOV 8 57 P 6 B 0 + 35 B W 24 hrs. NOV 20 57

OCT 13 57 NOV 20 57

DBA