
Kingman

SECTION 15 TOWNSHIP 29S RANGE 7W

WELL NO. #2-Burkenbaugh (Barkenbaugh)

COMPANY W. J. Coppinger

NE NE SW

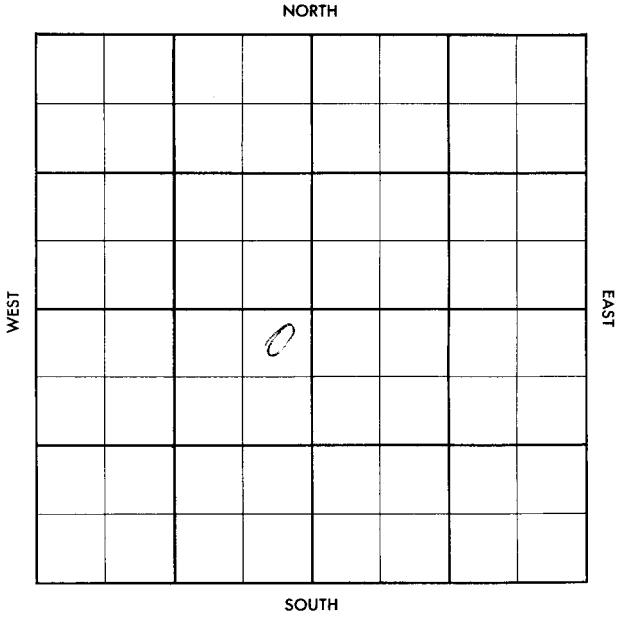

KANSAS

Kingman

SEC.	TWP.	R.
15	29 S	7 W

WELL NO.


2 Burkenbaugh FARM

COMPANY

W. J. Coppinger

CONTRACTOR

D & M
Voran

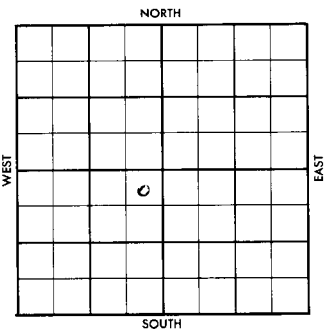

_____ FT. FROM N. LINE

_____ FT. FROM S. LINE

_____ FT. FROM E. LINE

_____ FT. FROM W. LINE

NE NE SW

SLX-Offset

1957	ELEVATION REPORT	
7/24	Location	(JR Tkt)

FORM 513 SUNRAY

County Kingman Elev.

Sec. 15 Twp. 29 Rge. 7W

Company W. J. Coppinger

Farm Name Burkenbaugh No. 2

TOPS	DEPTH	LOG	DATUM
Anh.			
Tp.			
H.			
Tr.			
Dg.			
Bl.			
L.			
K.C.			
B.K.C.			
Ce.			
C.			
M.			
M.			
K.			
Mz.			
Mo.			
V.			
S.			
S.			
A			
R.			
P€.			
G.			
TD		SDX	

Loc. in Sec. NE NE SW

Geol.

Contr. D & M

Pool Woran

FIRST REPORT

JUL 24 '57

Offset

Date Comm.

Location

Co.

Lse.

No.

Sec.

T.

R.

Trenton

FORM 513 SUNRAY

County Kingman Elev. 1600 Co.

Sec. 15 Twp. 29 Rge. 7W

Company W. J. Coppinger

Farm Name Burkanbaugh No. 2X2

TOPS	DEPTH	LOG	DATUM
Anh.			
Twp.			
H.	3104		
Tr.	3148		
Dg. sd	3195		
Bl.			
L.	3347	3347	1747
K.C.			
B.K.C.		3841	2241
Ce. Miss		3890	2290
C.			
M.		4130	2530
M.			
K.		4384	2784
Mz.			
Mo.			
V.		4493	2893
S.			
S.			
A			
R.			
P€.			
G.			
TD	4508		

Loc. in Sec. NE NE SW

Geol.

Contr. D & M

Pool Voran

DEC 18 '57

COMPLETE

Lse. No. Sec. T. R.

Date Comm.

Location AUG 31 '57 AUG 8 '57 7-31-57

8 5/8 257/200 ✠ 2815 SEP 14 '57

DST 3752-65 1 hr. 140' MSW

+550 BHP 1286 ✠ 4002 AUG 31 '57

DST 4491-4506 op 1 hr R. 3300' G 0.1 Gr. 42°

BHP 1605/20" 5½ 4496 w 10 sx wo cf

AUG 28 '57 SEP 4 '57 C O 4508 Flwd Nat

10 5 BO 1/16" 24 hrs CP 125

TST SEP 11 '57 SEP 17 '57 SEP 25 '57

FORM SIS-1 SUNRAY

OCT 2 '57 OCT 9 '57 OCT 16 '57

OCT 30 '57 NOV 6 '57 NOV 13 '57

NOV 20 '57 NOV 27 '57 DEC 4 '57 DEC 11 '57

DEC 18 '57 TD 10 thru csg

allow 3790 pd NW

V 4496-4508 TD

15-29-7W NE NE SW