

Grant KANSAS

15

29

37 W

Section _____ Township _____ Range _____


1 Carter

Well No. _____

Hugoton Prod.

Company _____

NORTH

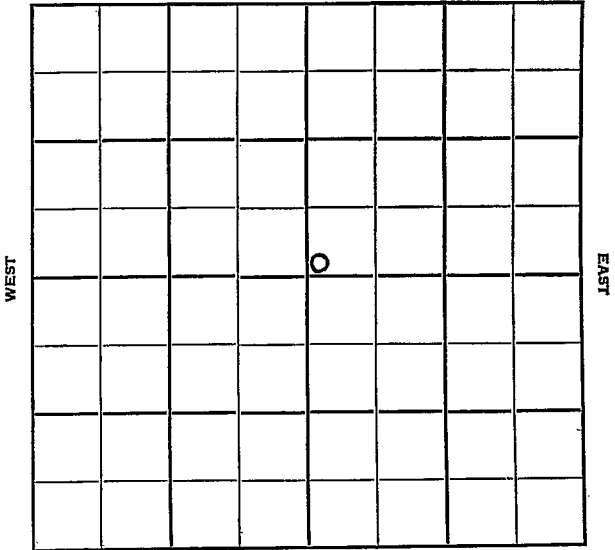

SOUTH

Grant

KANSAS

Sec. 15 Twp. 29 R. 37 W

Well No. # 1 Carter Farm

Hugoton Prod. Company

Contractor

Hugoton Pool


Ft. from N. Line

170 Ft. from S. Line

Ft. from E. Line

170 Ft. from W. Line

SW NE

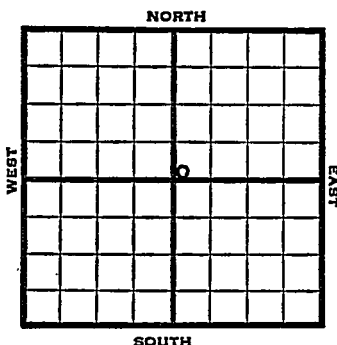

1951

Elev. 3007' REPORT

12/12

Location

1952

1/16

Spud 12-15-51

Gas well TD 2596' 10" @ 485

7" @ 2353 TD 2596' Her. 2360'

Kri 2383' Win 2442' Ft. Riley 2506

22,000 A

Comp. 31,898,000 gas

COMPLETED


Sec. 15 (Blk. Twp.) 29 (Sur. Rge.) 37W Map No.

Operator Hugoton Prod.

Well No. **1** Farm **Carter**

Elev.	Location	SW	NE
-------	----------	----	----

FIRST REPORT

170 Ft. From S Line NE

170 Ft. From W Line Quarter

1st. Report DEC 1 2 1951.

Completion

Remarks

Spudding Date _____

Drlg. Data Hugoton Pool

Location

J. E. TYRA

County Grant State Kansas

Sec. 15 (Blk.) 29 (Sur.) 37W Map No.

Operator Hugoton Prod.

Well No. 1 Farm Carter

Elev. 3007 Location SW NE

0

COMPLETE