


Section 15 Township 29 Range 39W

Well No. 1 Jones "A"

Company Stanolind

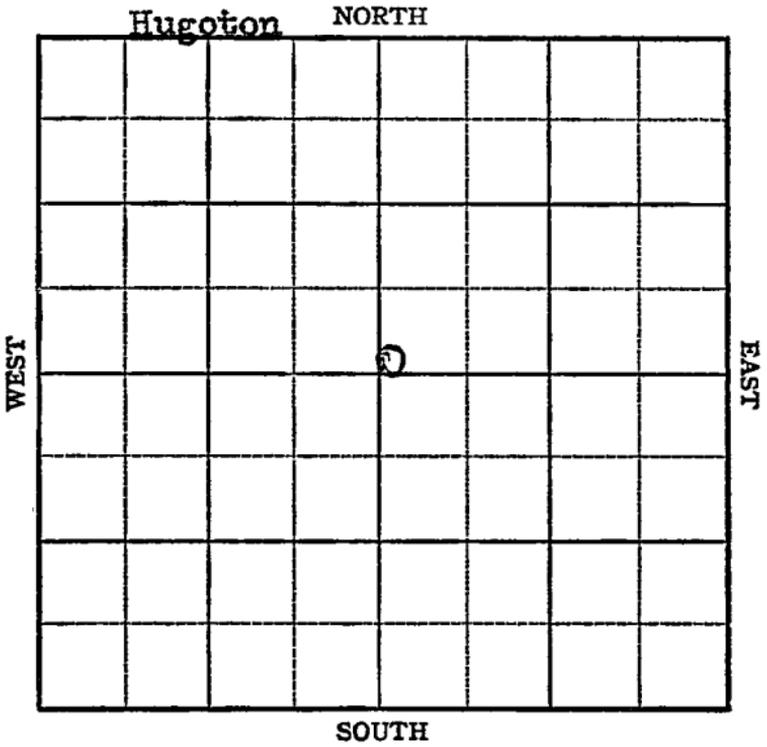

KANSAS

Stanton

15

29

39W

Sec. _____ Twp. _____ R. _____

Well No. #1 Jones "A" _____ Farm

Stanolind _____ Company
Hugoton

_____ Ft. from N. Line

50


_____ Ft. from S. Line

_____ Ft. from E. Line

50

_____ Ft. from W. Line

SW NE

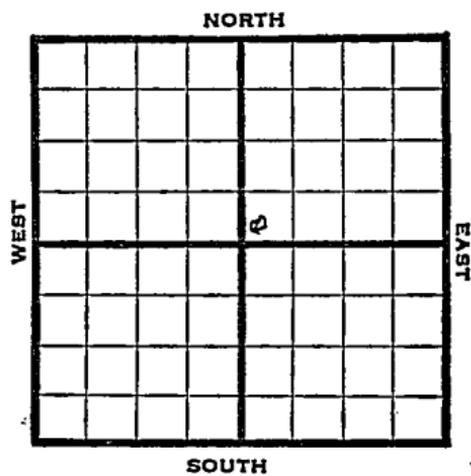

1947

Elev. 3191: REPORT

9/10

10" @ 615
drlg. 1759

9/17

7" @ 2380'
227' of 5" Perf Liner @ 2534'
2000 Acid
410# Rock Pressure
4,000,000 cu ft Gas
Total Depth 2534'

COMPLETED

Map No. _____ Sec. 15 Twp. 29 R. 39W

Well No. 1 Jones "A"

Stanöind Company

FIRST REPORT

Contractor

SW NE


SECTION PLAT

_____ Ft. from N. Line

50 Ft. from S. Line

_____ Ft. from E. Line

50 Ft. from W. Line

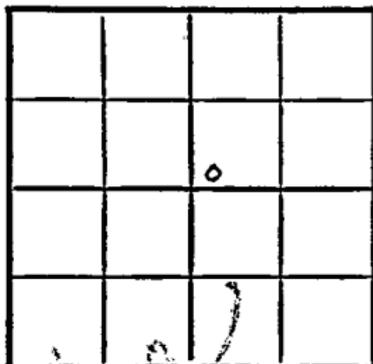

Stanton County

Location _____

Rig up _____

Drilling and Remarks:

10" @ 615

drlg. 1759

RECORD

Cased _____ in, _____ ft.

Sand _____

Gas _____

Oil _____

Total Depth _____

PRODUCTION

1st 24 hrs. Nat. _____

1st 24 hrs. after shot _____

Gas _____ Cu. Ft.

Dry Hole _____

Abandoned _____

Date

SEP 10 1947 19

S. J. LEWIS Scout

Map No. 17 Sec. 15 Twp. 29 R. 39W

Well No. I Jones "A"

Stanolind Company

COMPLETE

Contractor

SW NE

E13191
SECTION PLAT

50 Ft. from N. Line

50 Ft. from S. Line

50 Ft. from E. Line

50 Ft. from W. Line

Stanton County

Location _____

Rig up _____

Drilling and Remarks:

7" @ 2880
227' of 5" Pipe lined
@ 2534
2000' casing
4 M. Gas

410 # RPE

RECORD

Cased _____ in., _____ ft.
 Sand _____
 Gas _____
 Oil _____
 Total Depth 534

PRODUCTION

1st 24 hrs. Nat. _____
 1st 24 hrs. after shot _____
 Gas _____ Cu. Ft.
 Dry Hole _____
 Abandoned _____

Date

SEP 17 1947

19

S. J. LEWIS Scout