

Hasklell


KANSAS

SECTION 15 TOWNSHIP 29 RANGE 33 W

WELL NO. #1 Brennam

COMPANY Michaelis Drlg.

NORTH

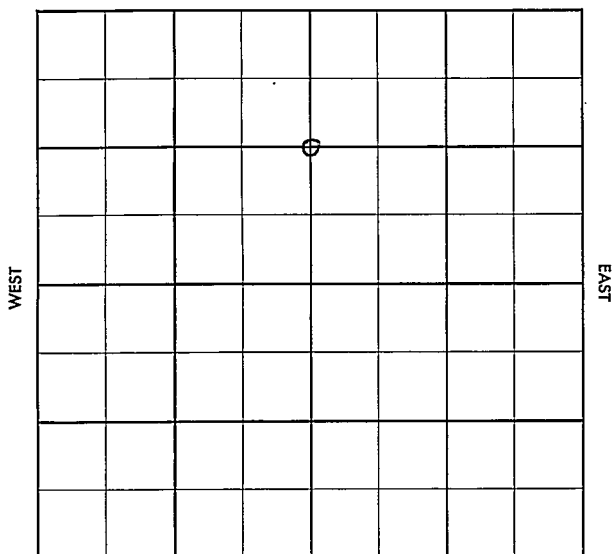

SOUTH

Haskell

KANSAS

SEC.	TWP.	R.
15	29	33W

WELL NO.

#1 Brennan

FARM

COMPANY

Michaelis Drlg.

CONTRACTOR

Co. tools


Hugoton

Ft. from N. Line

Ft. from S. Line

Ft. from E. Line

Ft. from W. Line

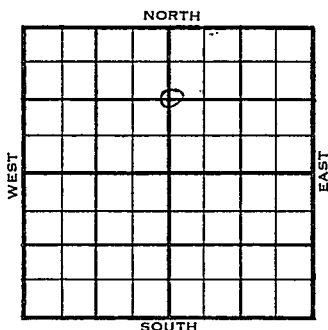C N $\frac{1}{2}$ Sec.

	ELEVATION	REPORT
1956	2950	
1-5	Comm. 1-2-56 8" @ 579/300 WOC	
2-1	5 $\frac{1}{2}$ " @ 2740 DD 2749 220 mcfg 1000 A, 960 mcfg, 6000 A 1,746 mcfg, PB 2713, 40/2660-70, 64/ 2690-2706 Frac, 3,738 mcfg, 4000 A, 4,295 mcfg, 6000 A CO to 2749 Comp. 10,775 mcfgpd Log tops: U. Kri 2651 L. Kri 2683 Winf. 2725 TD 2744'	

COMPLETED

County Haskell Elev. _____
 Sec. 15 Twp. 29 Rge. 33W
 Company Michaelis Drlg.
 Farm Name Brennan No. 1

TOPS	DEPTH	LOG	DATUM	Loc. in Sec. _____
Anh.				<u>C N$\frac{1}{2}$ Sec.</u>
Tr.				
H.				
Tr.				
Dg.				
BL.				
L.				Geol. _____
K.C.				Contr. _____
B.K.C.				<u>Co. tools</u>
Ce.				Pool _____
C.				<u>Hugoton</u>
M.				
M.				
K.				
Mz.				
Me.				
V.				
S.				
S.				
A.				
R.				
P.C.				
G.				
T.D.				

JAN 5 '56	
FIRST REPORT	

Date Comm. 1-2-56
8" @ 579/300 WOC

[Handwritten signature]

JAN 9 1956

R. G.

County Haskell Elev. 2950
 Sec. 15 Twp. 29 Rge. 33W
 Company Michaelis Drlg.
 Farm Name Brennan No. 1

TOPS	DEPTH	LOG	DATUM	Loc. in Sec.
Anh.				C N $\frac{1}{2}$ Sec.
Tr.				
H. <u>U. Kri</u>		<u>2651</u>		
Tr. <u>L. Kri</u>		<u>2683</u>		
Dg. <u>Winf</u>		<u>2725</u>		
Bl.				
L.				Geol.
K.C.				Contr.
B.K.C.				Co. tools
Ce.				
C.				Pool
M.				Hugoton
M.				
K.				
Mz.				
Me.				
V.				
S.				
S.				
A.				
R.				
Pe.				
G.				
T.D.	<u>2744</u>			

COMPLETE

Date Comm. 1-2-56 FEB 1 1956

8" @ 579/300 5 $\frac{1}{2}$ " @ 2740 DD 2749

220 mcfg 1000 A 960 mcfg 6000 A

1,746 mcfg PB 2713 40/ 2660-70

64/ 2690-2706 frac 3,738 mcfg

4000 A 4,295 mcfg 6000 A

CO to 2749 Comp. 10,775 mcfgpd

FEB 9 1956

R. G.