FORM 51


Stanton

KANSAS

Section 15 Township 29 Range 40 W

Well No. # 1 Kelman

Company Stanolind

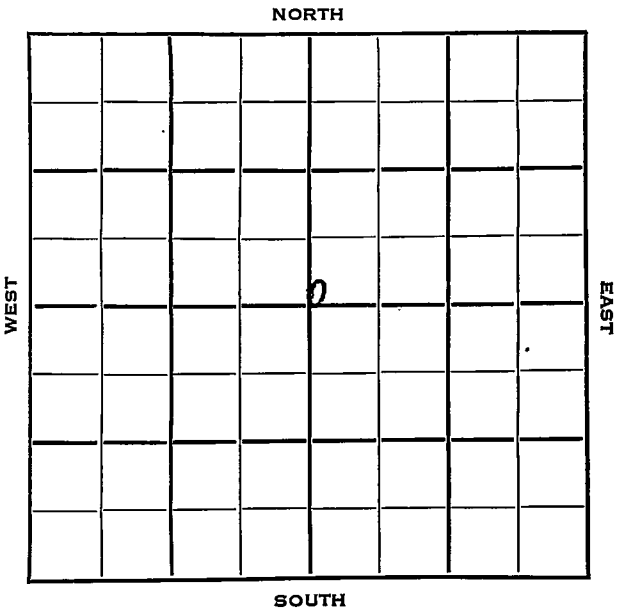

Stanton KANSAS

SEC.	TWP.	R.
15	29	40 W

WELL NO. # 1 Kelman FARM

COMPANY Stanolind

CONTRACTOR

Hugoton Pool


_____ Ft. from N. Line

150 Ft. from S. Line

_____ Ft. from E. Line

150 Ft. from W. Line

SW SW NE

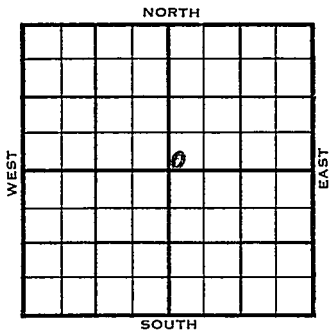

1953	ELEVATION 3273'	REPORT
11/18		Spud 11-14-53 8" @ 646 Drlg. 1200'
12/16		Spud 11-14-53 Gas Well TD 2420' 8" @ 646' Her. 2216', Win 2290', Tow 2352' Ft. Riley 2406' 5½" @ 2406' TD 2420' CO to 2420' frac PB 2390 12/ 2352-54 48/ 2358-66 60/ 2370-80 frac PB 2344 60/ 2218-28 36/ 2250-56 36/ 2262-68 60/ 2290-2300 60/ 2316-26 frac Comp 1,515,000 gas 375#.

COMPLETED

DX-78

FORM 275 FOR SALE BY KANSAS BLUE PRINT CO.


County Stanton State Kansas

Sec. 15 (Blk. Twp.) 29 (Sur. Rge.) 40W Map No.

Operator Stanolind

Well No. 1 Farm Kelman

Elev. Location SW SW NE

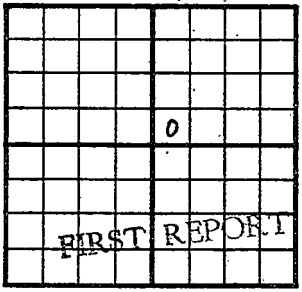

150 Ft. From S Line NE

150 Ft. From W Line Quarter

1st. Report NOV 18 1953

Completion

Remarks

Spudding Date 11-14-53

Drlg. Data Hugoton Pool

8" @ 646 drlg. 1200

J. G. McGEHEE

FORM 275 FOR SALE BY KANSAS BLUE PRINT CO.


County Stanton State Kansas

Sec. 15 (Blk. Twp.) 29 (Sur. Rge.) 40W Map No.

Operator Stanolind

Well No. 1 Farm Kelman

Elev. 3273 Location SW SW NE

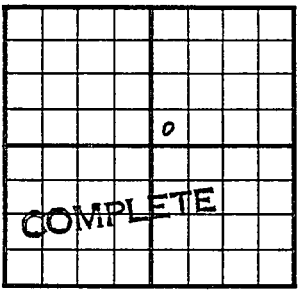

150 Ft. From S Line NE

150 Ft. From W Line Quarter

1st. Report

Completion DEC 16 1953

Remarks Hugoton Pool

Spudding Date 11-14-53

Drlg. Data Gas well TD 2420

8" @ 646 Her. 2216 Win. 2290

Tow. 2352 Ft. Riley 2406 5½" @ 2406

TD 2420 CO to 2420 frac PB 2390

12/ 2352-54 48/ 2358-66 60/ 2370-80

frac PB 2344 60/ 2218-28 36/ 2250-56

36/ 2262-68 60/ 2290-2300 60/ 2316-26

frac Comp. 1,515,000 gas 375#

J. G. McGEHEE