

Stanton

KANSAS

15

29

41W

SECTION _____ TOWNSHIP _____ RANGE _____


#1 Arnold

WELL NO. _____

Martin-Jamenson

COMPANY _____

NORTH C SE

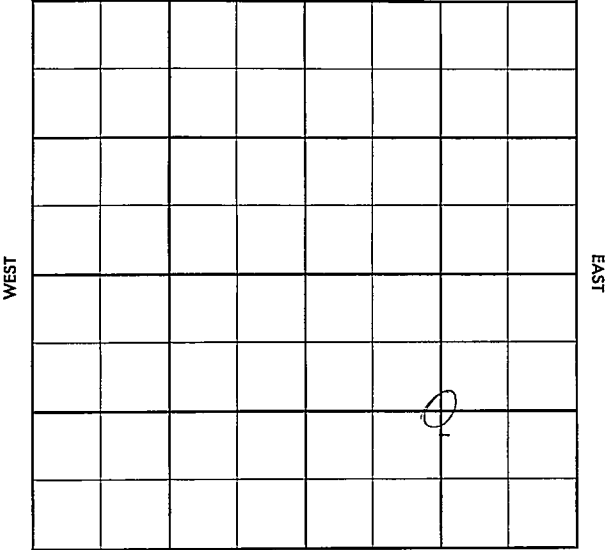

SOUTH

WILDCAT

FORM 513 SUNRAY

County Stanton

Elev. _____

Sec. 15

Twp. 29

Rge. 41W

Company Martin-Jamenson

FarmName Arnold

No. 7

TOPS	DEPTH	LOG	DATUM
Anh.			
TP.			
H.			
Tr.			
Dg.			
Bl.			
L.			
K.C.			
B.K.C.			
Ce.			
C.			
M.			
M.			
K.			
Mz.			
Mo.			
V.			
S.			
S.			
A.			
R.			
PE.			
G.			
T.D.			

Loc. in Sec. _____

C SE

Miss Test

Geol. _____

Contr. Graham-

Michaelis Tls

Pool _____

Wildcat

FIRST REPORT	

Date Comm. 3-8-57 Superior (FO)

8" @ 1578/800, WOC

SA

Co.

Loc.

T

No.

Sec.

T.

R.

FORM 513 SUNRAY

5408
3392
2016

County Stanton Elev. 3392 KLB
 Sec. 15 Twp. 29 Rge. 41W
 Company Martin-Jamenson
 Farm Name Arnold No. 1

TOPS	DEPTH	LOG	DATUM
Anh.			
Tp. <u>W26</u>	<u>2965</u>		
H. <u>EM</u>	<u>3160</u>		
Tr. <u>FP</u>	<u>3325</u>		
Dr.			
Bt. <u>LC CP</u>	<u>3495</u>		
L. <u>H6</u>	<u>3625</u>		
K.C. <u>TR</u>	<u>3650</u>		
BKC. <u>LS9</u>	<u>3685</u>		
Ce.			
C.			
M. <u>Marm</u>	<u>4284</u>		
M. <u>MW Sh</u>	<u>4961</u>		
K. <u>SDY2R</u>	<u>5295</u>		
Mz. <u>MW3</u>	<u>5390</u>		
Mo. <u>MISS</u>	<u>5408</u>		
V.			
S.			
A.			
R.			
PE.			
G.			
TD.	<u>5505</u>		

Loc. in Sec. C SE
Miss Test
 Geol. _____
 Contr. Graham-Michaelis Tls
 Pool Wildcat
 ABANDONED
 APR 10 '57

Date Comm. 3-8-57 Superior (FO)

8" @ 1578/800, WOC MAR 20 '57

DST 3224-85 1hr 465' SW.
FP 65-265 BHP 565/30"
DST 3339-81 1hr 40' Md + 180'
USGCWM FP 45-120 BHP 600
130 DST 3867-84 1hr 150' SG CWM
+ 900' GC5W FP 0-520 BHP 895
120 @ 3980 MAR 27 '57 DST 4460-95
1hr 15' Md BHP 895/20" S.P.

APR 7 '57

DST 5298-5395 2600 115'

WM + 450' SW FP 120-285'

BHP 1235/20" P 5:435" APR. 10 '57

REO

15-29-410'

CSE