

Kiowa

KANSAS

16

29S

18W


SECTION _____ TOWNSHIP _____ RANGE _____

WELL NO. #1 A.E. Peters

COMPANY Gulf Oil

NORTH

C SW/4

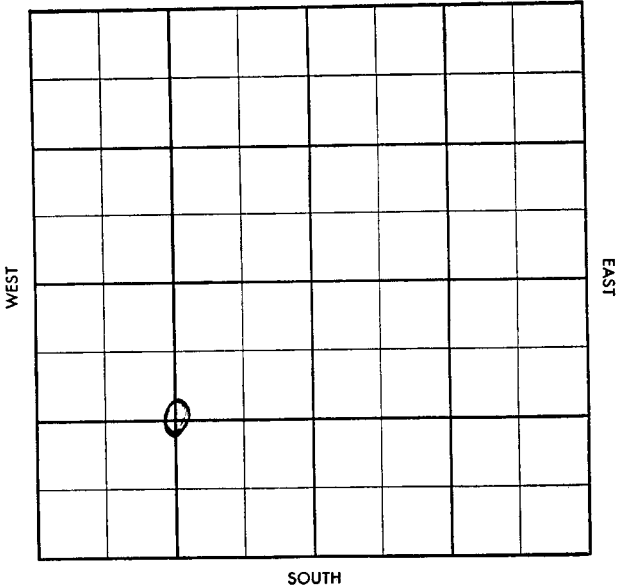

Nichols

S-513-A

CO. Kiowa ELEV. 22080
SEC. 16 TWP. 29S RGE. 18W ABANDONED
COMPANY Gulf Oil NO. 1

FARM A. E. Peters

LOC. C SW $\frac{1}{4}$ 1251' FSL x 1251' FWL

GEOL. _____

CONTR. Falcon-Seab

POOL Nichols

SPUD _____

WORT _____

8 $\frac{5}{8}$ 412/300

NOV 20 57 Ø 438

NOV 20 57 Hb 4102

Dg 4146 BL

LKC 4292 M

4910 PST 4912-41 60

g/4" ga 88 mcf/15" 44

25/50" m 195' gcm

1-P 190-120 BHP 6601

MLi 4941 RTD 5001

Ran log Hb 4106 Dg 4

BL 4279 LKC 4291 M

4892 MLi 4946 DST 4

-4949 (DPR) 60

g/46" ga 104 mcf 195' 590

FP 50-6.0 BHP 1150-390/3

TD 5001

DTA