


Section 16 Township 29 Range 7 W

Well No. # 1 Brand

Company Cities Service Oil

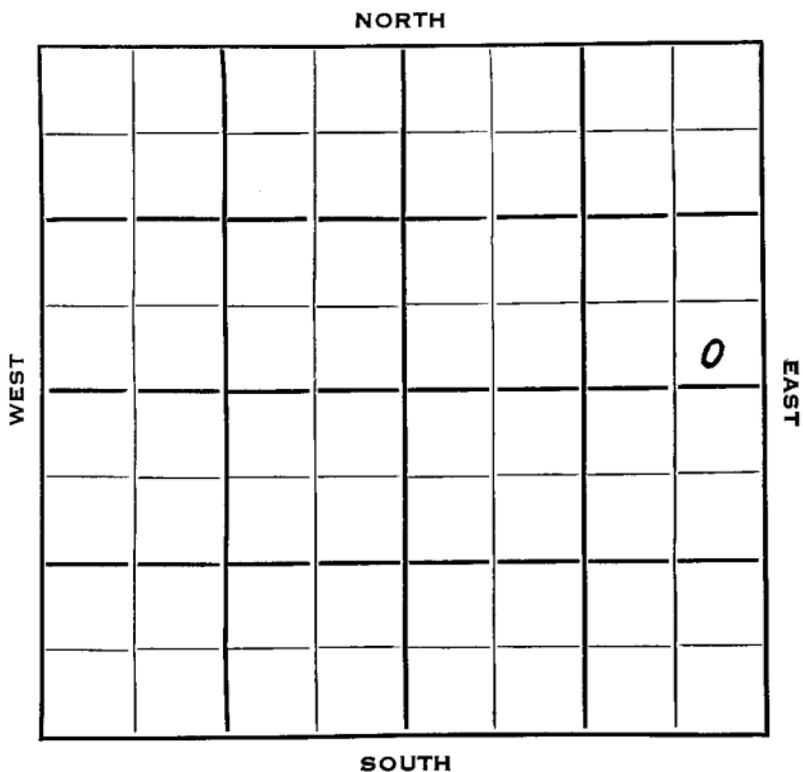

Sec. 16 Twp. 29 R. 7 W

Well No. # 1 Brand Farm

Cities Service Oil Company

Brack Drlg. Contractor

Basil Pool


 Ft. from N. Line

220 Ft. from S. Line

450 Ft. from E. Line

 Ft. from W. Line

SE SE NE

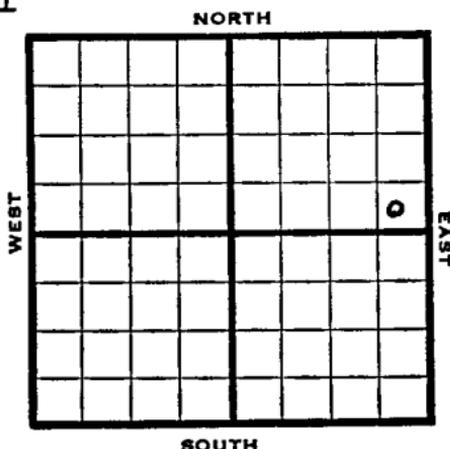

1953

Elev. 1602' REPORT

5/13

Spud 5-9-53
12" @ 90 8" @ 278

5/21

Lans 3352
Drlg 3385'

5/28

Drlg.

6/3

Miss 4130 KH 4385 Meisner 4498
V 4513 RTD 4516 5" @ 451A

6/10

CO 4516 S/62 BW & trace oil 3 1/2 hrs.
PB 3830 45/3763-74 1000 A
S/180 BO plus 125 BW 22 hrs. PB 3745
35/3727-37 FU 2925' oil 1-3/4 hrs.
HFO 3-3/4 hrs. F/35 BO 2 1/2 hrs.

6/24

S&F 126 BO + 27 BW 10 hrs.
G. 34.3
CO 3830'

7/1

NR

7/8

Spud 5-9-53 Oil well TD 4516
12" @ 90 8" @ 278 Lans 3352
DST 3728-40 open 1 hr gas in 19 min
rec 1120' GCO, 40' MCO 1455#
DST 3766-76 open 1 hr rec 90' OCM
60' GCM, 1350# Miss 4130
DST 4198-4205 open 1 hr rec 35' SW
1275#

OVER

1953

7/8

(Information continued)

Kh. 1385 Misener 4498 Viola 4513

TD 4516 5" @ 4514 CO to 4516

S/62 BW Dr. oil $3\frac{1}{2}$ hrs.

PB 3830 45/3763-74 1000 A

S/180 BO 125 BW 22 hrs. PB 3745

35/3727-37 FU 2925' oil 1- $\frac{3}{4}$ hr.

HFO 3- $\frac{3}{4}$ hr. F/35 BO 2 $\frac{1}{2}$ hrs.

S & F/126 BO 27 BW 10 hrs.

CO to 3830

Comp. 294 BOPD 18% wtr.

COMPLETED

County Kingman State Kansas

Sec. 16 (Blk. Twp.) 29 (Sur. Rge.) 7W Map No.

Operator Cities Service Oil

Well No. 1 Farm Brand

Elev. _____ Location SE SE NE



220 Ft. From S Line NE

450 Ft. From E Line Quarter

1st. Report MAY 13 1953

Completion _____

Remarks _____

Brack Drlg. - Contr.

Spudding Date 5-9-53

Drlg. Data _____ Basil Pool

12" @ 90 8" @ 278

