


Section 16 Township 29 Range 7W

Well No. #1 Brand

Company W. E. Green

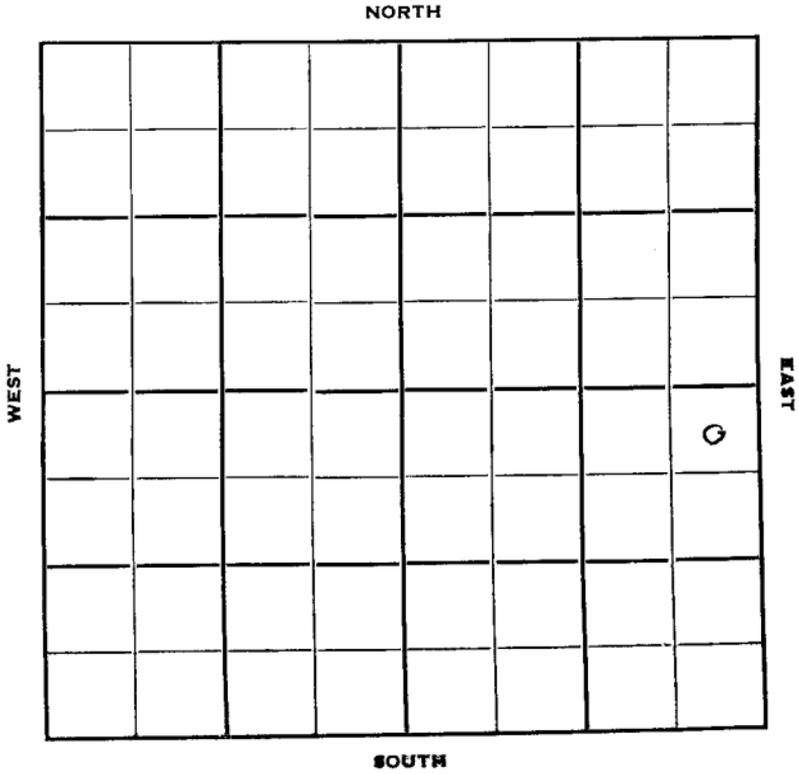

Sec. 16 Twp. 29 R. 7 W

Well No. # 1 Brand Farm

W. E. Green Company

Coppinger Contractor


Wildcat

330 Ft. from N. Line

Ft. from S. Line

330 Ft. from E. Line

Ft. from W. Line

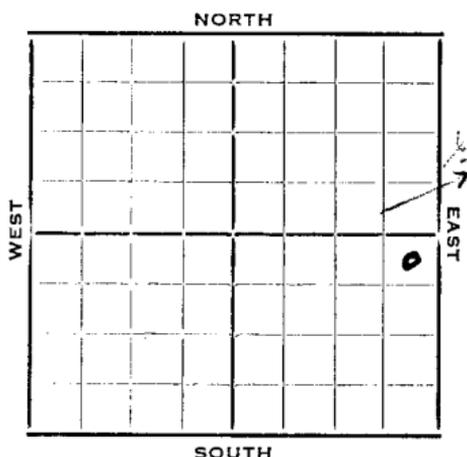

NE NE SE

MCPC has NE of 15
 ISO - \$5000 DHM

1952	Elev. 1603'	REPORT
11/5	Location	
1/12	8" @ 191'	
11/20	Drlg. 3121'	
11/27	Douglas 3257, Br Li 3369', Lans 3372 DST 3740-48, 1 hr., 300' gas, 60' socsw 1365#	
12/4	DST 3774-82, opn 1 hr., rec. 220' SOCM, 90' SW, 1375# DST 3816-26, opn 1 hr. rec. 55' M&W 1500# Miss 4132 DST 4149-85, opn 3/4 hrs., rec. 75000 cfg Viola 4511 DST 4512-18, opn 47 mins., F 1 oil 47 mins., rec. 2600' oil 15' OCM, 75' mud & W 1450# Simp 4522-35, DST 4522-52, opn 1 hr., rec. 930' SW, 1530#	
12/11	Arb 4636 RTD 4666 5" @ 4602 KH 4393 Misner 4500	
12/18	CO 4521 log 6/4511-12 FU 400' Oil 1 H 6/4512-13 FU 1200' Oil 1/2 Hr. 6/4513 14 FU 2500' oil 1/2 Hr. F 6 S BO Died S/19 BO 1st hr 19 BO 2nd Hr S/24 BO 3rd Hr POP	

1952

12/31 Setting tanks. Will send information as soon as we can get a pump test. The last test was S/24 BO 1 hr. (Ltr)

1953

1/1

NR

1/8

F 28 BO 2 Hrs. died G 42.5 Raised tub.
F 27 BO 50 mins. died S/62 BO 5 Hrs.
S/12 BOY
5 BWPB CO 4517 3500' Fluid in 25 hrs.
NC BREAKDOWN

1/22

NR

1/29

Completed for a State test of 211 BOPD (MCPC has NE/4 of Sec 15-29S-7W.)

(Ltr-McGhe

1/28

Spud 11-10-52 Oil well TD 4666'
9" @ 191 Doug. 3257' Br. lime 3369'
Lans. 3372'
DST 3740-48 open 1 hr. rec 300' gas,
60' SOCSW 1365#
DST 3774-82 open 1 hr. rec 220' SOCM
90' SW 1375#
DST 3816-26 open 1 hr. rec 55' mud & wt
1500# Miss 4132'
DST 4149-85 open 3/4 hr. gas in 5 min
rec 75,000 CFG Viola 4511'
DST 4512-18 open 47 min F/691 47 min
2600' oil, 15' OCM, 75' mud & wtr.
1450#
Simp. 4522-35
DST 4522-52 open 1 hr. rec 930' SW
1530# Arb. 4636' TD 4666'
5" @ 4602 Kh. 4393' Misener 4500'
CO to 4521 6/4506-11 Dry
1/4512 6/4511-12 FU 400' oil 1 hr
6/4512-13 FU 1200' oil 1/2 hr.
F/65 BO died. S/19 BO 1 hr. 19 BO
2nd hr. S/24 BO 3rd hr. F/28 BO 2 hr
F/27 BO 50 min. S/62 BO 5 hr. S/12
BO 5 BWPB CO to 4517 FU 3500' flui
25 hr.
Comp. 211 BOPD

COMPLETED

County **Kingman** State **Kansas**

Sec. **16** (Blk. **29**) (Sur. Rge.) **7** Map No.

Operator **W. E. Green**

Well No. **1** Farm **Brand**

Elev. Location **NE NE SE**

330 Ft. From **N** Line **SE**

330 Ft. From **E** Line Quarter

1st. Report **NOV 5 1952**

Completion

Remarks **CSO - \$5000 DEM**


Coppinger - Contr.

Spudding Date

Drig. Data **MCPC has NE of 15 Wildcat**

Location

County Kingman State Kansas
 Sec. 16 (Blk. Twp.) 29 (Sur. Rge.) 7W Map No.
 Operator W. E. Green
 Well No. 1 Farm Brand
 Elev. 1603 Location NE NE SE

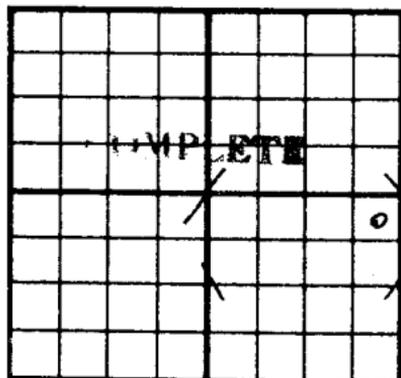

330 Ft. From N Line SE
330 Ft. From E Line Quarter

1st. Report

Completion JAN 28 1953

Remarks Wildcat

Coppinger - Contr.

Spudding Date 11-10-52

Drig. Data Oil well TD 4666

9" @ 191 Doug. 3257 Br. lime 3369

Lans. 3372 DST 3740-48 open 1 hr.

Rec. 300' gas 60' socsw 1365# DST 3774

82 open 1 hr. Rec. 220' socm 90' sw

1375# DST 3816-26 open 1 hr. Rec. 55'

mud & wtr. 1500# Miss. 4132 DST 4149

85 open 3/4 hr. gas in 5 min. Rec.

75,000 cfg Viola 4511 DST 4512-18

open 47 min. F/ oil 47 min. 2600' oil

15' ocm 75' mud & wtr. 1450#

Simp. 4522-35 DST 4522-52 open 1 hr.

Rec. 930' sw 1530# Arb. 4636 TD 4666

5" @ 4602 Kh. 4393 Misener 4500

CO to 4521 6/ 4506-11 dry 1/ 4512

J. G. McGEHEE

Orig. Data

6/ 4511-12 FU 400' oil 1 hr. 6/ 4512-13

FU 1200' oil $\frac{1}{2}$ hr. F/ 65 bo died

S/ 19 bo 1 hr. 19 bo 2nd hr. S/ 24 bo

3rd hr. F/ 28 bo 2 hr. F/ 27 bo 50 min

S/ 62 bo 5 hr. S/ 12 bo 5 bwph CO to

4517 FU 3500' fluid 25 hr.

Comp. 211 bopd

.....	Misc
.....	Piece Map
.....	Tracings
.....	Field Wall Map
.....	Small Map
.....	Notes Cards

mm

1953 FEB 4