


KANSAS Grant

FORM 51 5M 2-38 TPCO.

Section 16 Township 29 Range 36-W

Well No. 1 Howell

Company Panhandle Eastern

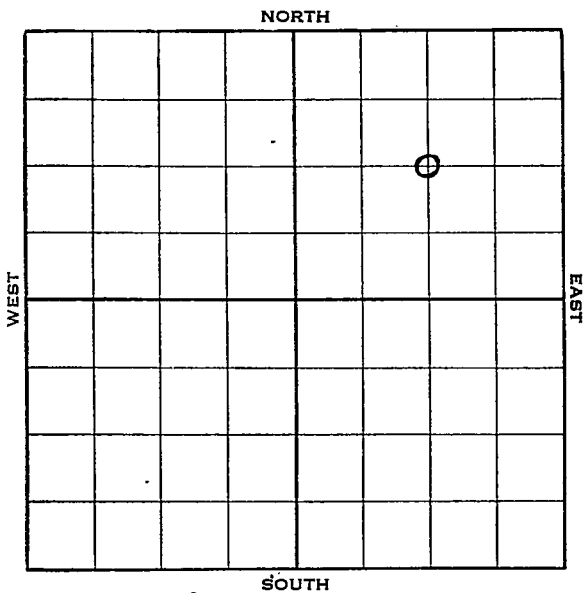

Sec. 16 Twp. 29 R. 36

Well No. #1 Howell Farm

Panhandle Eastern Company


1320 Ft. from N. Line

_____ Ft. from S. Line

1320 Ft. from E. Line

_____ Ft. from W. Line

Elev. 3030
~~3025~~

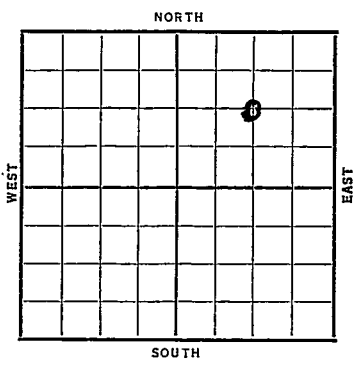

Date	REPORT
1938	
3/9	Drlg. 265'.
3/18	Drlg. 850'.
3/25	10" @ 550'. 7" @ 2450'. WOC.
4/1	Drlg. 2530'.
4/8	T.D. 2761'. 5 M gas. 6000 acid.
4/15	13 M gas.
4/20	7" @ 2450'.
	Sand ?
	T.D. 2761'.
	6000 acid.
	13 M gas.
	COMPLETED

Map No. 111 Sec. 16 Twp. 29 R. 36W

Well No. 1 Howell

Panhandle Eastern

Company

Contractor

FIRST REPORT

SECTION PLAT

C NE

1320 Ft. from N. Line

_____ Ft. from S. Line

1320 Ft. from E. Line

_____ Ft. from W. Line

		○	
		X	15

Location _____

Rig up _____

Drilling and Remarks:

Drig. 265

RECORD

Cased _____ in., _____ ft.

Sand _____

Gas _____

Oil _____

Total Depth _____

PRODUCTION

1st 24 hrs. Nat. _____

1st 24 hrs. after shot _____

Gas _____ Cu. Ft.

Dry Hole _____

Abandoned _____

Date

MAR 9 - 1938

19

H. D. Hatfield Scout

Map No. NM Sec. 16 Twp. 29 R. 36W

Well No. 1 Howell

Panhandle Eastern Company

Contractor

COMPLETED

C NE

1320 Ft. from N. Line

_____ Ft. from S. Line

1320 Ft. from E. Line

_____ Ft. from W. Line

SECTION PLAT

		⊙	

Location _____

Rig up _____

Drilling and Remarks:

6000 acid
13 M gas

RECORD

Cased 7 in., 2450 ft.

Sand _____

Gas _____

Oil _____

Total Depth 2761

PRODUCTION

1st 24 hrs. Nat. _____

1st 24 hrs. after shot _____

Gas _____ Cu. Ft.

Dry Hole _____

Abandoned _____

Date **APR 20 1938**

19 H. D. Hatfield Scout