

KANSAS


FORM 51 5M 6-46 PETROL

Pratt County

Section 18 Township 29 Range 12W

Well No. #1 Brubaker "B"

Company Bridgeport

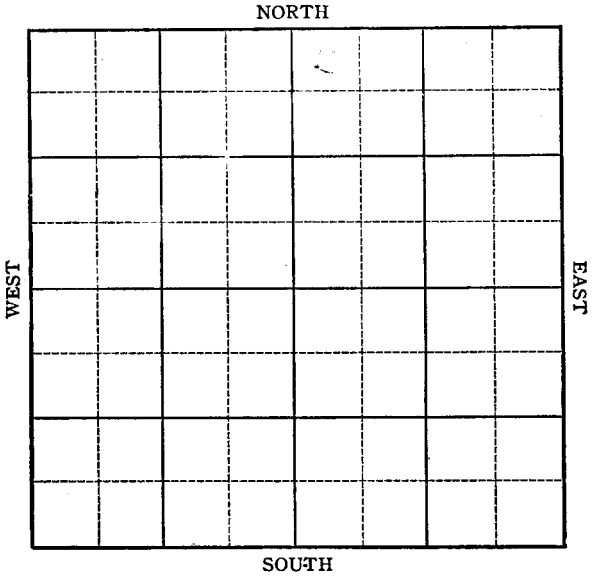

Sec. 18 Twp. 29 R. 12W

Well No. #1 Brubaker "B" Farm

Bridgeport Company

Stoops


330 Ft. from N. Line

Ft. from S. Line

Ft. from E. Line

330 Ft. from W. Line

NW NE

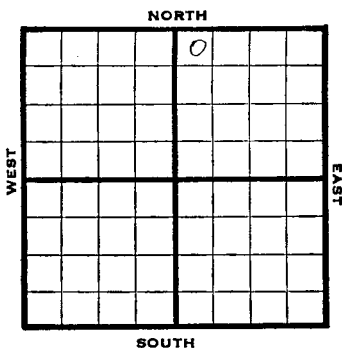

1946

REPORT

7/17	Location		
7/23	8" @ 860'		
	Drlg 1885'		
7/30	Drlg 3705'		
8/6	Drlg 4256'		
3/13	Miss 4295'		
	Viola 4441-		
	TD 4448		
	5" @ 4443 RUST		
8/20	TD 4457-4000 acid		
	swb fluid PH 16 hrs.		
8/27	"	"	"
9/5	"	"	"
9/10	"	"	"
9/18	"	"	"
9/24	"	"	"
10/1	"	"	"
10/8	"	"	"
10/15	"	"	"
10/22	"	"	"
10/29	"	"	"
11/6	"	"	"
11/12	"	"	"

OVER

1946

11/20

Viola 4441'

5" @ 4443'

TD 4457'

4000 Acid

Pump 101 oil plus 15% W Pot

40 Grav.

COMPLETED

KANSAS
Map No. 57 Kansas Pool Name Stoops
Sec. 18 Twp. 29 R. 12W

Well No. 1 Brubaker "B"

Bridgeport Company

FIRST REPORT

Contractor

NW NE

SECTION PLAT

		0	

330 Ft. from N. Line

_____ Ft. from S. Line

_____ Ft. from E. Line

330 Ft. from W. Line

Prett County

Location X

Rig up _____

Drilling and Remarks:

RECORD

Cased _____ in., _____ ft.

Sand _____

Gas _____

Oil _____

Total Depth _____

PRODUCTION

1st 24 hrs. Nat. _____

1st 24 hrs. after shot _____

Gas _____ Cu. Ft.

Dry Hole _____

Abandoned _____

Date

JUL 17 1946 19

S. J. LEWIS Scout

Map No. 54 Sec. 18 Twp. 29 R. 12W

Well No. 1 Brubaker "B"

Bridgeport Company

COMPLETED Contractor

NW NE

E. 1906
SECTION PLAT

330 Ft. from N. Line

 Ft. from S. Line

 Ft. from E. Line

330 Ft. from W. Line

		0	

Pratt County

RECORD

Location

Cased in., ft.

Rig up

Sand

Drilling and Remarks:

Gas

Vista 4441

Oil

5" 04443

Total Depth 4452

4000 acid

Pump 101 2 1/2 + 15%

W. P. T

40° 48'

PRODUCTION

1st 24 hrs. Nat.

1st 24 hrs. after shot

Gas Cu. Ft.

Dry Hole

Abandoned

Date

NOV 20 1946 19

S. J. LEWIS Scout