


Section 18 Township 29 Range 32W

Well No. #1 Leonard

Company Kansas Natural Gas

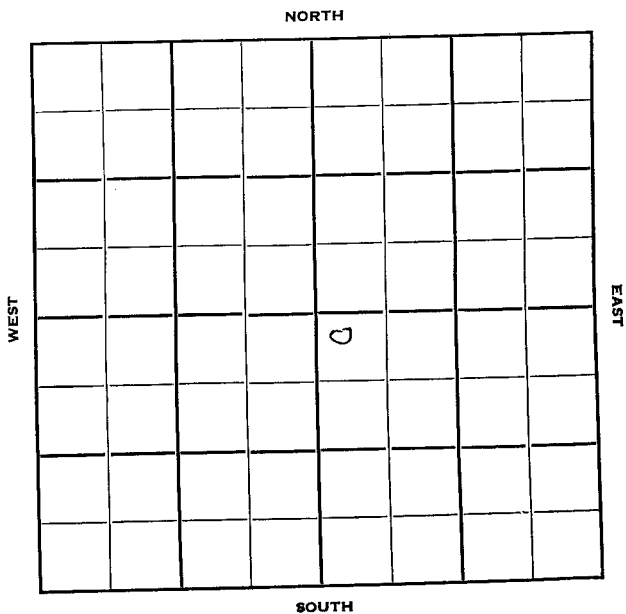

Haskell

KANSAS 32W
R.

Sec. 18 Twp. 29

Well No. #1 Leonard Farm

Kansas Natural Gas Company

Contractor


Hugoton Pool

100 Ft. from N. Line

Ft. from S. Line

Ft. from E. Line

100 Ft. from W. Line
SE 1/4 NW SE

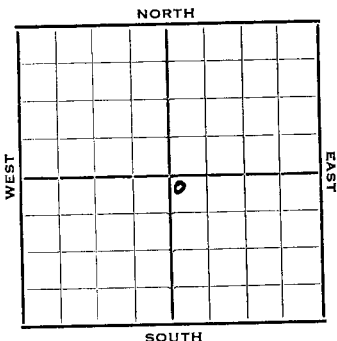

1952

Elev. 2923'

REPORT

10/29 Spud 10-26-52
 11/5 10" @ 556'
 Her 2638, Krider 2662, Winfield 2713'
 RTD 2716
 7" @ 2716'
 11/12 NR
 11/20 "
 11/27 "
 12/4 "
 12/11 TD 2723 60/2640-50 132/2664-86
 13,000A
 12/17 Spud 10-26-52
 Gas Well
 TD 2723
 10" @ 556
 Her. 2638, Kri 2662, Win 2713
 TD 2716
 7" @ 2716 DD 2723 60/2640-50
 132/2664-86 13000A
 Comp. 5,750,000 gas

COMPLETED

