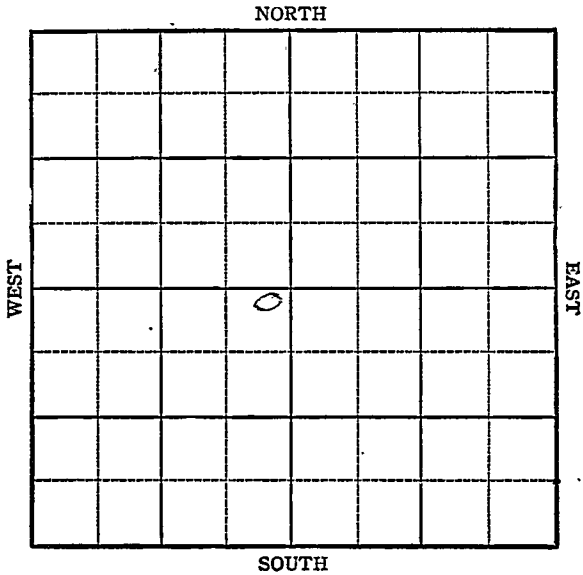


, KANSAS

Section 18 Township 29 Range 33WWell No. #1 UnruhCompany United Prod.

Haskell

Sec. 18 **KANSAS** Twp. 29 R. 33W

Well No. #1 Unruh Farm

United Prod. Company


Hugoton

100 Ft. from N. Line

 Ft. from S. Line

100 Ft. from E. Line

 Ft. from W. Line

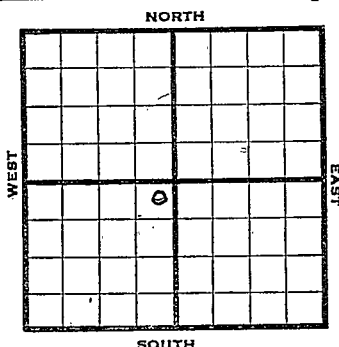

NE SW

1944

R E P O R T

9/20 Location

9/28 "

10 /4 "

10/11 "

10/18 Drk.

10/25 "

11/1 ' RUR

11/8 TD 2745

229' of 5" of Perf. liner @ 2745

11/16 7" @ 2531' RUST

11/24 228' off 5' perf liner and 2725 TD

11/29 n 8000 Acid

12/6 7" @ 2531'

228' of 5" Perf Lin r @ 2725

TD 2725

8000 acid

12,659,000 Gas

425# R PR.

COMPLETED

KANSAS

Pool Name HugotonMap No. NM Sec. 18 Twp. 29 R. 33WWell No. 1 UnruhUnited Prod

Company

FIRST REPORT

Contractor

NE SW

SECTION PLAT

100 Ft. from N. Line Ft. from S. Line100 Ft. from E. Line Ft. from W. Line

	0		

HaskellLocation XRig up

Drilling and Remarks:

RECORD

Cased in., ft.Sand Gas Oil Total Depth

PRODUCTION

1st 24 hrs. Nat. 1st 24 hrs. after shot Gas Cu. Ft.Dry Hole Abandoned

Date

SEP 20 1944

19

S. J. LEWIS

Scout

Pool Name HugotonMap No. N M Sec. 18 Twp. 29 R. 33WWell No. 1 Unruh

United Prod


Company

COMPLETED

Contractor

NE SW

SECTION PLAT

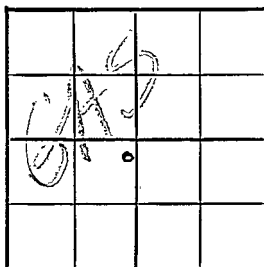100 Ft. from N. Line Ft. from S. Line100 Ft. from E. Line Ft. from W. Line

Haskell

Location

Rig up

Drilling and Remarks:

7" C 2531

2 28 1/2" Perf. Liner

C 2 725.

8000 acft

12,659,000 Gas

425 * R Pt

RECORD

Cased _____ in., _____ ft.

Sand _____

Gas _____

Oil _____

Total Depth 2725

PRODUCTION

1st 24 hrs. Nat. _____

1st 24 hrs. after shot _____

Gas _____ Cu. Ft.

Dry Hole _____

Abandoned _____

Date

DEC 6 1944

19

S. I. LEWIS Scout