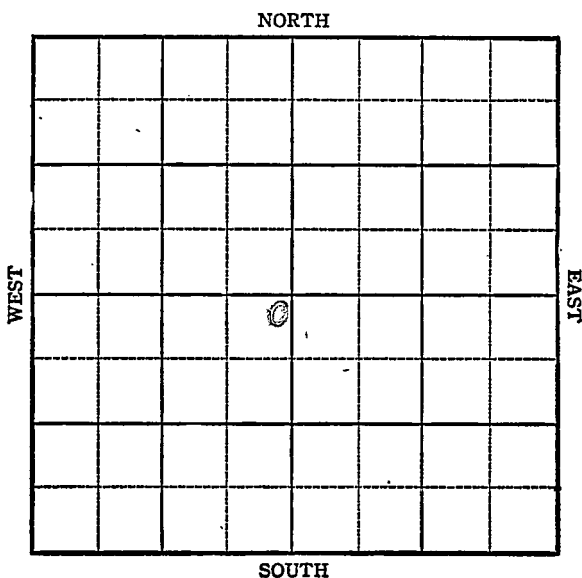


KANSAS

Haskell

~~Haskell~~Section 18 Township 29 Range 34WWell No. #1 Taylor-AnthonyCompany United Prod

KANSAS

Haskell

Sec. 18 Twp. 29 R. 34W

Well No. #1 Taylor-Anthony Farm

United Prod Company

Hugoton


100 Ft. from N. Line

 Ft. from S. Line

100 Ft. from E. Line

 Ft. from W. Line

Elev 3019

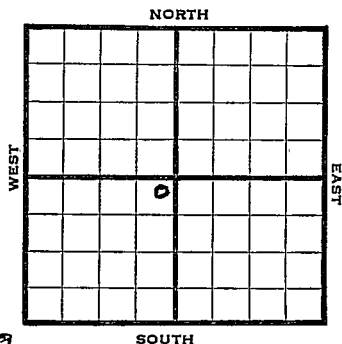

1944

REPORT

7/26	Location
8/2	Surface hole
8/9	10" @ 670 Drlg. 715
8/16	7" @ 2534 RUST
8/23	" " " "
8/30	" " " "
9/8	" " " "
9/13	" " " "
9/21	" " " "
9/28	TD 2740
10/4	220' of 5" Perf. liner @ 2743 TD
10/11	" " " " " " " "
10/18	" " " " " " " 3 M. ga
10/25	1000 acid
11/1	8000 acid
11/8	" "
11/15	7" @ 2534
	220' of 5" Perf. liner @ 2743
	8000 acid
	TD 2743
	15 M Gas

COMPLETED

Pool Name HugotonMap No. KANSAS Sec. 18 Twp. 29 R. 34 WWell No. 1 Taylor- AnthonyUnited Prod. Company

FIRST REPORT

Contractor

NE SW

SECTION PLAT

100 Ft. from N. Line Ft. from S. Line100 Ft. from E. Line Ft. from W. LineHaskell CountyLocation XRig up

Drilling and Remarks:

RECORD

Cased in., ft.Sand Gas Oil Total Depth

PRODUCTION

1st 24 hrs. Nat. 1st 24 hrs. after shot Gas Cu. Ft.Dry Hole Abandoned

Date

JUL 26 194419S. J. LEWIS Scout

Pool Name Hugoton PoolMap No. N 1/2 Sec. 18 Twp. 29 R. 34 WWell No. 1 Taylor-AnthonyUnited Prod.


Company

COMPLETED

Contractor

NE SW

SECTION PLAT

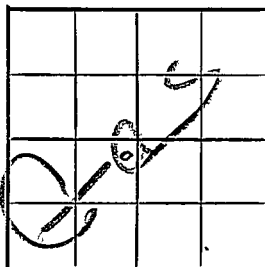100 Ft. from N. Line Ft. from S. Line100 Ft. from E. Line Ft. from W. LineHaskell CountyLocation Rig up

Drilling and Remarks:

7" 02534220' 2 1/2" Pay/level02743Good acid15 M Gas

RECORD

Cased in., ft.Sand Gas Oil Total Depth 2243

PRODUCTION

1st 24 hrs. Nat. 1st 24 hrs. after shot Gas Cu. Ft.Dry Hole Abandoned

Date

NOV 15 1944 19S. J. LEWIS

Scout