

DX 78-1


Kiowa

KANSAS

Section 19 Township 29 Range 16W

Well No. #1 Miller

Company Aurora-Gasoline

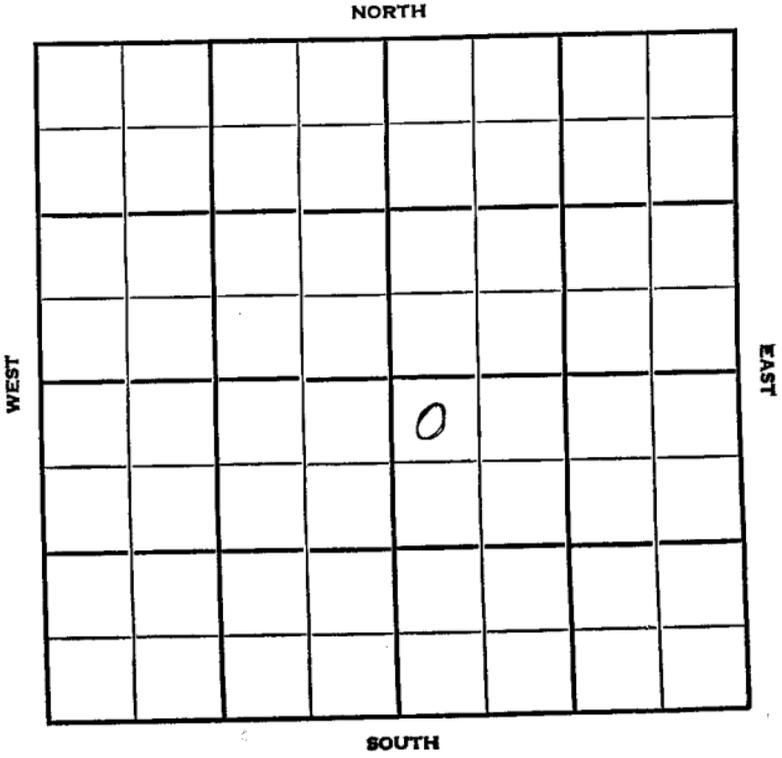

WILDCAT

FORM 513 SUNRAY

County Kiowa Elev. _____
Sec. 19 Twp. 29 Rge. 16W
Company Aurora Gasoline
Farm Name Miller No. 1

TOPS	DEPTH	LOG	DATUM
Anh.			
Tp.			
H.			
Tr.			
Dg.			
Bl.			
L.			
K.C.			
B.K.C.			
Ce.			
C.			
M.			
M.			
K.			
Mz.			
Mo.			
V.			
S.			
S.			
A.			
R.			
PE.			
G.			
ED.			

Loc. in Sec. NW NW SE
Geol. _____
Contr. Graybol Tools
Pool Wildcat
FIRST REPORT
NOV 28 '56

Date Comm. RURT
 25

Loc. No. 1. T.

County Keowa Elev. 2041
 Sec. 19 Twp. 29 Rgs. 16W
 Company Aurora Gasoline
 Farm Name Miller No. 1

TOPS	DEPTH	LOG	DATUM	
Ans				<u>321' FNL</u>
Tr.	<u>3972</u>			<u>354' FWL of</u>
Dg				<u>2550' H.L.</u>
Bl.				<u>2300' E.E.</u>
L.	<u>4150</u>			Geol.
K.C.				Contr.
B.K.C.				<u>Graybol Tool</u>
Ce.				Pool
C.				<u>Wildcat</u>
M.	<u>4701</u>			ABANDONED
M.				
K.				
Mz.				
Me.				
V.				
S.				
S.				
A.				
R.				
Pe.				
G.				
TD	<u>4802</u>			<u>DEC 20 '56</u>

Date Comm. 1
RURT
DEC 9 '56 11-27-56 8 3/8 226
1130 @ 3065 DEC 12 '56 174346
DEC 19 '56 DST 4703-15 30" 180'
HMC0 + 720' Free oil + 1170' SW
EP 50-1500 BHP 1640/20" #
DST 4744-55 1hr 30' @ Mud
BHP 350/20
D & A (To much SW, & Logging
Tool in hole)