

DX 78-1


Kiowa

KANSAS

Section 19 Township 29 Range 18 18W

Well No. #1 Corse

Company Gulf Oil

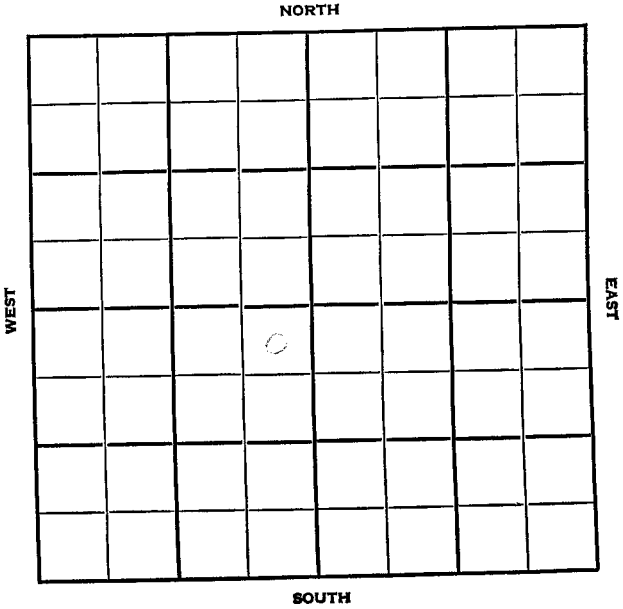

Kiowa

KANSAS


SEC.	TWP.	R.
19	29	18W
WELL NO.		
1 Corse		
COMPANY		FARM
Gulf Oil		
CONTRACTOR		

330' _____ Ft. from N. Line

_____ Ft. from S. Line

330' _____ Ft. from E. Line

_____ Ft. from W. Line

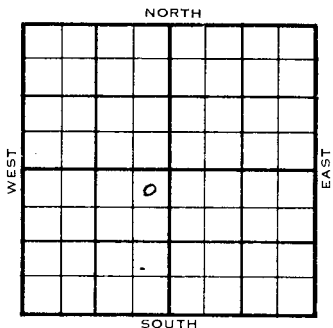

NE NE SW

ELEVATION		REPORT
L955	25' 11"	
5/1	Location	COMPLETED
7/13	Comm 6-1-55	
	8 5/8"-@356/109 DST 4518-22 open 1 h	
	Rec. 25' so spk mud 48/15" DST 4952-	
	5003 open 1 hr. gas to surface in 3 mi	
	1,200 mcfg 1,630 mcfg Rec. 210' gcm 16	
	50/30" 4 1/2" @5049/125 CO to 5020 76/	
	4972-90 32/4956-64 550 mcfg 500 A frac	
	F/8,520 mcfg F/6,905 mcfg F/5,850 mcfg	
	Comp shut in gas well ind cap 10 mcfg.	
	Tops	Depth Datum
	H.	4139 1868
	Dg.	4194 1923
	BL	4329 2058
	L.	4341 2070
	M. ch	4956 2685
	N. Lm	5010 2739
	TD.	5050

DX-78

County Kiowa State KansasSec. 19 (Blk. Twp.) 29 (Sur. Rge.) 18W Map No.Operator Gulf OilWell No. 1 Farm CorseElev. Location NE NE SW

330 Ft. From N Line SW330 Ft. From E Line Quarte1st. Report JUN 1 1955

Completion

Remarks

Spudding Date

Drlg. Data

Nichols Pool

Location

County Kiowa Elev. 2271
 Sec. 19 Twp. 29 Rge. 18W
 Company Gulf Oil
 Farm Name Corse No. 1

TOPS	DEPTH	LOG	DATUM	Loc. in Sec.
Anh.				NE NE SW
Tr.				
Dg.				
BL.				
L.				
K.C.				Geol.
B.K.C.				Contr.
Ce.				
C.				
M.				
M.				Pool
N. Lin				Nichols
Mz.				
Me.				
V.				
S.				
S.				
A.				
R.				
Pe.				
G.				
TD.				

Date Comm. 6-1-55 JUL 13 1955
 8 5/8" @ 356/109 DST 4518-32 open
 1 hr. Rec. 25' so spk mud 48/15"
 DST 4952-5003 open 1 hr. gas to
 surface in 3 min. 1,200 mcfg 1,630 mcfg
 Rec. 210' gcm 1650/30" 4 1/2" @ 5049/125
 CO to 5020 76/ 4972-90 32/ 4956-64
 550 mcfg 500 A frac F/ 8,520 mcfg
 F/ 6,905 mcfg F/ 5,850 mcfg
 Comp. shut in gas well ind. cap. 10 mcfg

OVER