


KANSAS

Pratt County

Section 19 Township 29 Range 13W

Well No. #1 Wagner

Company Lion Oil Ref.

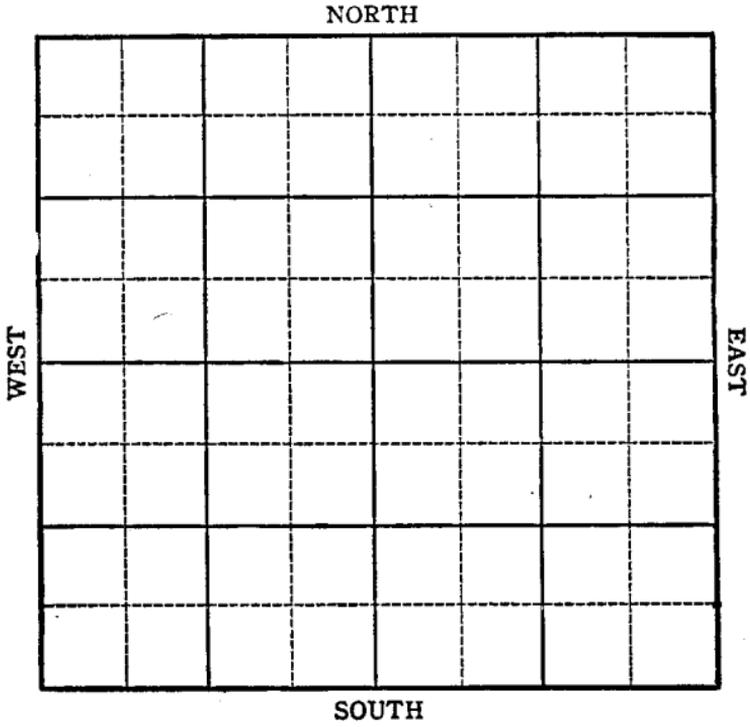


KANSAS *Special* Pratt County

Sec. 19 Twp. 29 R. 13W

Well No. #1 Wagner Farm

Lion Oil Ref. Company

Coats

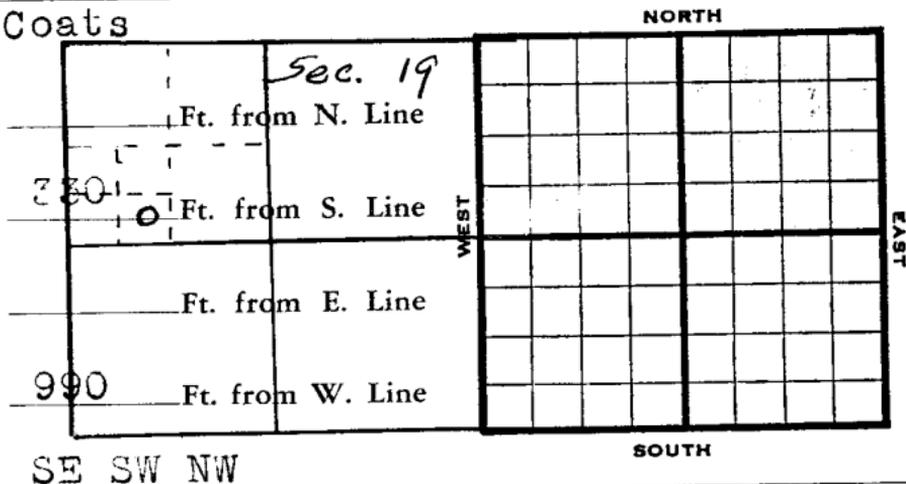

1944

R E P O R T

11/8 Derrick

11-15 Set 8" @ 495'
Drilling 2050'

11/22 Drilging 3850'

11-29 Lansing 3937
Viola 4401 ??
Simpson Sd 4527-45
Total Depth 4545 Stain.

12/6 Simp. Sd. 4527
TL 4568' in Simp.

ABANDONED

Pool Name Coats

Map No. 92 Sec. 19 Twp. 29 R. 13 W

Well No. 1 Wagner

Lion Oil Ref. _____ Company

FIRST REPORT _____ Contractor

SE SW'NW

SECTION PLAT

_____ Ft. from N. Line

330 Ft. from S. Line

_____ Ft. from E. Line

990 Ft. from W. Line

Pratt

Location _____

Rig up _____

Drilling and Remarks:

derrick

Not Filed

RECORD

Cased _____ in., _____ ft.

Sand _____

Gas _____

Oil _____

Total Depth _____

PRODUCTION

1st 24 hrs. Nat. _____

1st 24 hrs. after shot _____

Gas _____ Cu. Ft.

Dry Hole _____

Abandoned _____

Date

NOV 8 1944 19

S. J. LEWIS Scout

Pool Name Coats

Map No. 92 Sec. 19 Twp. 29 R. 13W

Well No. 1 Wagner

Lion Oil Ref. Company

ABANDONED Contractor

SE SW NW

SECTION PLAT

	6		

 Ft. from N. Line

330 Ft. from S. Line

 Ft. from E. Line

990 Ft. from W. Line

Pratt

Location

Rig up

Drilling and Remarks:

Shurf Sol 4527
4568 in Surf

RECORD

Cased in., ft.

Sand

Gas

Oil

Total Depth 4568

PRODUCTION

1st 24 hrs. Nat.

1st 24 hrs. after shot

Gas Cu. Ft.

Dry Hole

Abandoned

Date

DEC 6 1944 . 19

 Scout