


Map No. Kansas Sec. 19 Twp. 29 R. 1Well No. 1 Johnson FarmCurtis et al Company

NORTH

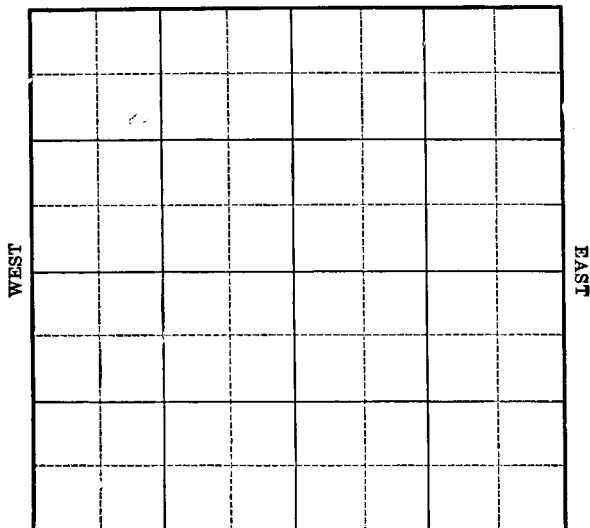

SOUTH

Location _____

Drilling Remarks _____

RECORD

Cased _____ in. _____ ft.

Sand _____

Gas _____

Oil _____

Total Depth _____

Rig Up _____

Drilling Remarks _____

PRODUCTION

1st 24 hrs. Nat. _____

1st. 24 hrs. after shot _____

Gas _____ cu. ft.

Dry Hole _____

Abandoned _____

Map No. Kansas Sec. 19 Twp. 29 R. 1^W

Well No. 1 Johnston Farm


Curtis & Co. Company

1020 Ft. from N. Line

Ft. from S. Line

Ft. from E. Line

102' Ft. from W. Line

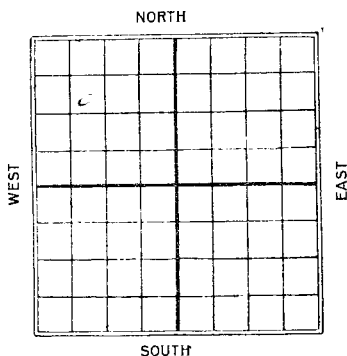

Benzol

Date _____

REPORT

1925

3/1	Location
-----	----------

6/5	Rip & tool.
-----	-------------

7/5

7/22	Regin up.
------	-----------

8/5 J.D. 14/0'

8/19	1710
------	------

8/27	2350'
------	-------

9/2	2650
-----	------

9/9	2760
-----	------

9/30 Oct 6" C 3225 L19 3265

10/6 Dig 3595

12/9 4000-4005 H.F.W.

L. & A. 4005

MAP NO. _____ SEC. 19 TWP. 29S R. 1WWELL NO. 1 Johnston
Curtis et al COMPANY

CONTRACTOR

SECTION PLAT

0			

_____ FT. FROM N. LINE

_____ FT. FROM S. LINE

_____ FT. FROM E. LINE

_____ FT. FROM W. LINE

LOCATION _____

RIG UP _____

DRILLING AND REMARKS:

1000-4005
 16'ileat
 H. J. H.
 OK with one
 wire

RECORD

CASED _____ IN. _____ FT.

SAND _____

GAS _____

OIL _____

TOTAL DEPTH 4005

PRODUCTION

1ST 24 HRS. NAT. _____

1ST 24 HRS. AFTER SHOT _____

GAS _____ CU. FT.

DRY HOLE ☒ABANDONED ☒

DATE

12/81928

SCOUT

Map No. KANSAS Sec. 19 Twp. 29 R. 1W

Well No. 1 Johnston

Curtis & Co Company

Contractor

SECTION PLAT

1020 Ft. from N. Line

_____ Ft. from S. Line

_____ Ft. from E. Line

1020 Ft. from W. Line

ABANDONED

Location _____

Rig up _____

Drilling and Remarks:

Wilcox

4000 & 4005

N. W. T. 11. 4005

11 & 11

RECORD

Cased _____ in., _____ ft.

Sand _____

Gas _____

Oil _____

Total Depth _____

PRODUCTION

1st 24 hrs. Nat. _____

1st 24 hrs. after shot _____

Gas _____ Cu. Ft.

Dry Hole _____

Abandoned _____

Date

DEC 9 1925

S. J. LEWIS

Scout

Map No. KANSAS Sec. 19 Twp. 29 R. 1WWell No. 1 JohnstonCurtis et al Company

Contractor

FIRST REPORT

1020 Ft. from N. Line

----- Ft. from S. Line

----- Ft. from E. Line

1120 Ft. from W. Line

SECTION PLAT

o			

Location ✓✓

Rig up -----

Drilling and Remarks:

RECORD

Cased ----- in., ----- ft.

Sand -----

Gas -----

Oil -----

Total Depth -----

PRODUCTION

1st 24 hrs. Nat. -----

1st 24 hrs. after shot -----

Gas ----- Cu. Ft.

Dry Hole -----

Abandoned -----

Date

3/1 1925

M. A. BENTLEY Scout