


Section 19 Township 29 Range 37 WWell No. # 1 WingerCompany Hugoton Prod.

NORTH

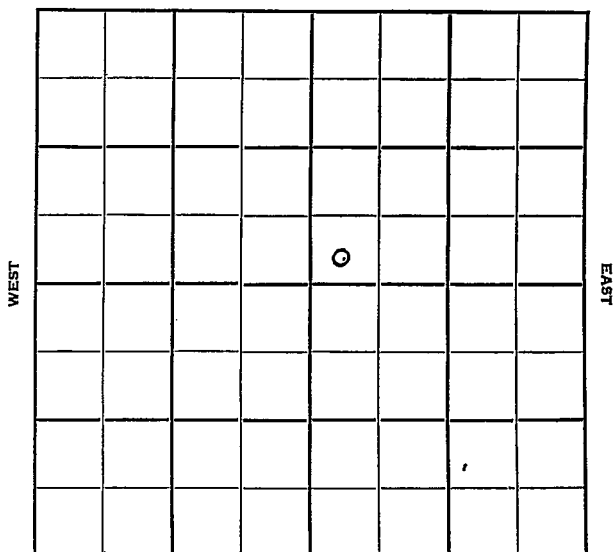

SOUTH

Grant

KANSAS

Sec. 19 Twp. 29 R. 37W

Well No #1 Winger Farm

Hugoton Prod. Company

Contractor

Hugoton Pool


2440' Ft. from N. Line

_____ Ft. from S. Line

2380' Ft. from E. Line

_____ Ft. from W. Line

SW NE

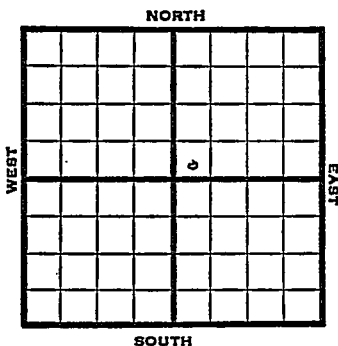

1951

Elev. 3120' REPORT

5/29

Location

8/22

Spud 6-2-51

Gas Well TD 2651

10" @ 538

7" @ 2395

TD 2651

Hol. 2375 Her. 2405

Krider 2438 Win. 2497

Ft. Riley 2560 13,250 A

Comp. 19,794,000 gas 420#

COMPLETED

County Grant State KansasSec. 19 (Blk. Twp.) 29 (Sur. Rge.) 37W Map No.Operator Hugoton Prod.Well No. 1 Farm WingerElev. Location SW NE

0

FIELD REPORT

2440 Ft. From N Line NE2380 Ft. From E Line Quarter1st. Report MAY 29 1951

Completion

Remarks

Spudding Date

Drlg. Data Hugoton PoolLocation

County Grant State Kansas

Sec. 19 (Blk. Twp.) 29 (Sur. Rge.) 37W Map No.

Operator Hugoton Prod.

Well No. 1 Farm Winger

Elev. 3120 Location SW NE

2440 Ft. From N Line NE

2380 Ft. From E Line Quarter

1st. Report

Completion AUG 22 1951

Remarks Hugoton Pool

Spudding Date 6-2-51

Drlg. Data Gas well TD 2651

10" @ 538 7" @ 2395 TD 2651

Hol. 2375 Her. 2405. Krider 2438

Win. 2497 Ft. Riley 2560 13250 A

Comp. 19,794,000 gas 420#

J. E. TYRA