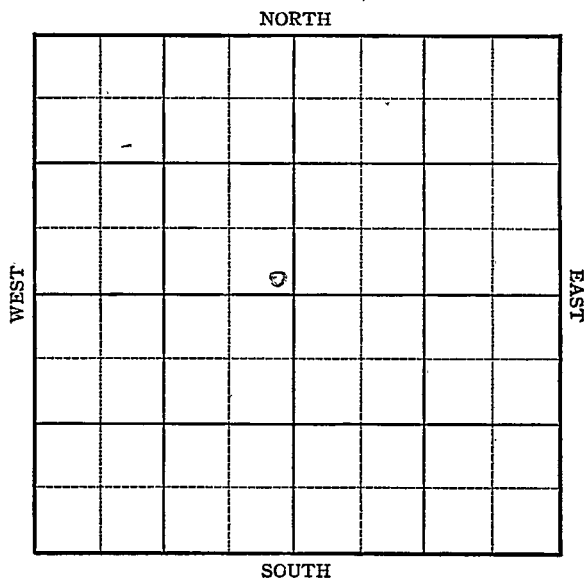


KANSAS

Grant

Section 19 Township 29 Range 35WWell No. #3 KingCompany United Prod.

KANSAS

Grant

Sec. 19 Twp. 29 R. 35W

Well No. #3 King Farm

United Prod.

Company


Hugoton

 Ft. from N. Line

100 Ft. from S. Line

100 Ft. from E. Line

 Ft. from W. Line

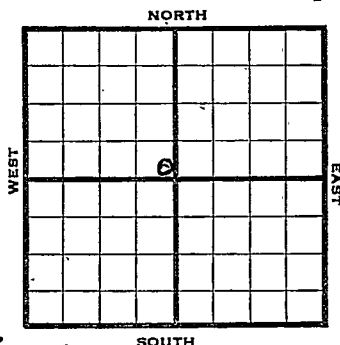

SE NW

Elev. 3030

1945

R E P O R T

3/7	10" - 640	WOC
3/14	7" @ 2530	RUST
3/23	TD 2720-228' of 5" Perf. liner @ 2720'	
3/29	" " "	" " " "
4/5	" " "	" " " "
4/12	8000 acid.	
4/20	" "	
4/25	7" @ 2530	
	228' of 5" Perf. liner @ 2720	
	TD 2720	
	8000 acid.	
	13,830,000 Gas	
	409# R Pr.	

COMPLETED

Pool Name HugotonMap No. No map Sec. 19 Twp. 29 R. 35WWell No. 3 KingUnited Prod


Company

-IRST REPORT

Contractor

SE NW

SECTION PLAT

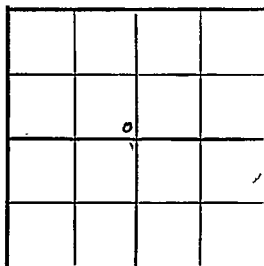 Ft. from N. Line100 Ft. from S. Line100 Ft. from E. Line Ft. from W. Line

Grant

Location Rig up

Drilling and Remarks:

10"-640 WOC

RECORD

Cased in., ft.Sand Gas Oil Total Depth

PRODUCTION

1st 24 hrs. Nat. 1st 24 hrs. after shot Gas Cu. Ft.Dry Hole Abandoned

Date

MAR 7 1945 19S. J. LEWIS

Scout

Kansas Pool Name HugotonMap No. no map Sec. 19 Twp. 29 R. 35WWell No. 3 King

United Prod. Company


COMPLETED

SE NW

Contractor

E. 3030

SECTION PLAT

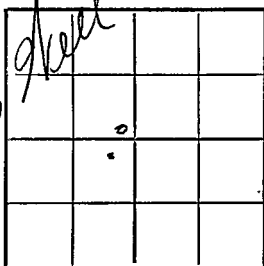

Ft. from N. Line

100 Ft. from S. Line100 Ft. from E. Line

Ft. from W. Line

Grant County

Location

Rig up

Drilling and Remarks:

7" @ 2530

225' of 5" Poly lined

@ 2720

7000 acid

13,780,000 Gas

405 # R. Pe

RECORD

Cased _____ in., _____ ft.

Sand _____

Gas _____

Oil _____

Total Depth 2720

PRODUCTION

1st 24 hrs. Nat. _____

1st 24 hrs. after shot _____

Gas _____ Cu. Ft.

Dry Hole _____

Abandoned _____

Date

APR 25 1945 19

S. J. LEWIS

Scout