

DX 78-1


Sedgwick

KANSAS

Section 2 Township 29 Range 2W

Well No. #1 Struthers

Company Woodriver Oil & Refg.

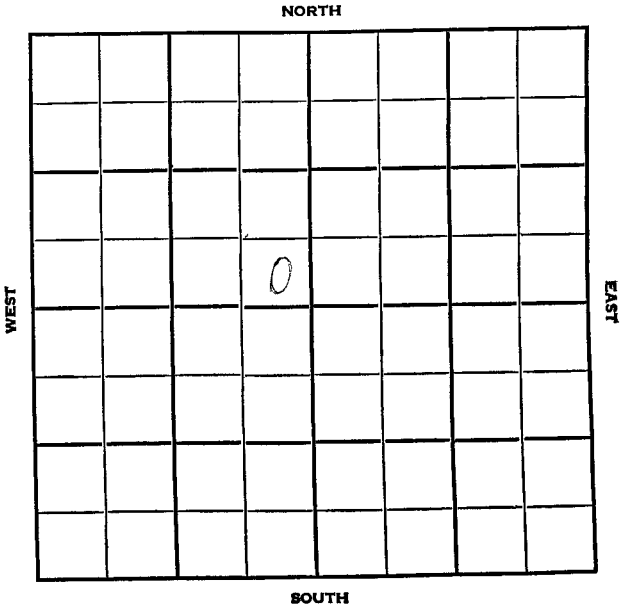

County **Sedgwick** Elev. \_\_\_\_\_  
 Sec. **2** Twp. **29** Rge. **2W**  
 Company **Woodraver Oil & Ref.**  
 Farm Name **Struthers** No. **1**


TOPS	DEPTH	LOG	DATUM
Anh.			
Tp.			
H.			
Tr.			
Dg.			
Bl.			
L.			
K.C.			
B.K.C.			
Ce.			
C.			
M.			
M.			
K.			
Mz.			
Me.			
V.			
S.			
S.			
A.			
R.			
Pe.			
G.			
TD			

Loc. in Sec. **SE SE NW**  
 Geol. \_\_\_\_\_  
 Contr. **Garvey**  
 Pool **NE Chamber**

NOV	7	1956
	0	
FIRST REPORT		

Date Comm. **11-2-56**  
**8" @ 450/300 drlg. 1199**

3021 S S 111W

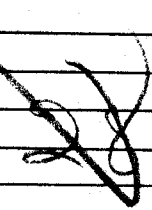

Co.  
 No.  
 Sec.  
 T.  
 R.

County Sedgwick Elev. 1367  
 Sec. 2 Twp. 29 Rge. 2W  
 Company Woodriver Oil & Ref.  
 Farm Name Struthers No. 1

TOPS	DEPTH	LOG	DATUM	Loc. in Sec.						
Anh.				SE SE NW						
Tp.										
H.										
Tr.										
Dg.										
Bl.										
L.	2944			Geol.						
K.C.				Contr.						
B.K.C.				Garvey						
Ce.				Pool						
C.				NE Chamber						
M.	3551			<table border="1"> <tr> <td colspan="2">COMPLETE</td> </tr> <tr> <td>o</td> <td></td> </tr> <tr> <td></td> <td>16 '57</td> </tr> </table>	COMPLETE		o			16 '57
COMPLETE										
o										
	16 '57									
M.										
K.										
Mz.										
Me.										
V.										
S.										
S.										
A.										
R.										
PE.										
G.										
TD.	3575									

Date Comm. 11-2-56  
8" @ 450/300 drlg. 1199 NOV 13 '56 NOV 21 '56  
DST 3551-65 1hr 6/55" rec  
15' Md 1330/20" DST 3565-75  
2hr 1hr 6/10" <sup>92</sup> rec 131 MCF rec  
65' oil + 60' Mdy oil NO BHP  
Recorded 5 1/2 @ 3573 MIST PD  
3590 tstg 3 Boph. no/w NOV 24 '56  
1/2 Flwd 4 Boph. no/w DEC 5 '56  
 DEC 12 '56 DEC 19 '56 DEC 26 '56 JAN 2 '57 JAN 9 '57 F/W