


Section 2 Township 29 Range 2W

Well No. #1 McLaughlin

Company Petroleum Inc.

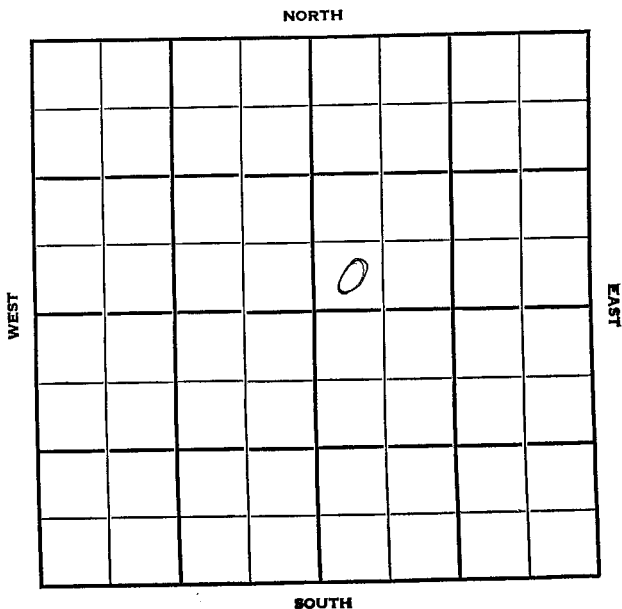

County Sedgewick Elev. _____
 Sec. 2 Twp. 29 Rge. 2W
 Company Petroleum Inc.
 Farm Name McLaughlin No. 1

	TOPS	DEPTH	LOG	DATUM
Anh.				
Tr.				
H.				
Tr.				
Dg.				
Bl.				
L.				
N.C.				
B.K.C.				
Ce.				
C.				
M.				
M.				
K.				
Mz.				
Me.				
V.				
S.				
S.				
A.				
R.				
PE.				
G.				
TD.				

Loc. in Sec. SW SW NE

Geol. _____
 Contr. Garry

Pool NE Chamber

NOV 21 1956

FIRST REPORT

Date Comm. 11-16-56
8" @ 150/275 drlg. 2645

218

Co.
 Loc.
 No.
 Sec.
 T.
 R.

Co.
No.
Sec.
T.
R.

County Sedwick Elev. 1359
 Sec. 2 Twp. 29 Rge. 2W
 Company Petroleum Inc.
 Farm Name McLaughlin No. 1

TOPS	DEPTH	LOG	DATUM
Anh.			
Tp.			
H.	<u>2329</u>		
Tr. <u>stall</u>	<u>2649</u>		
Dg.			
Bl.			
L.			
K.C.	<u>2922</u>		
B.K.C.			
Ce.			
C.			
M.	<u>3540</u>		
M.			
K.			
Mz.			
Mo.			
V.			
S.			
S.			
A.			
R.			
PE.			
G.			
TD.	<u>3580</u>		

Loc. in Sec. SW SW NE
 Geol. _____
 Contr. Garvey
 Pool NE Chamber

MAR 27 '57		
COMPLETE		

Date Comm. 11-16-56
8" @ 450/275 drlg. 2645 NOV 28 '56
5 1/2" @ 3570 DEC 5 '56 WOCT DEC 12 '56
CO. 3580 TST 6 G HOCM 100 ac.
TST 6 G FPH 540 W FVAC FLWD
20-B FPH 3090 WT 3/4" ch
9AS 9a 4,347 MCFG CP 500 #
 DEC 10 '56 DEC 6 '56 JAN 3 '57 JAN 3 '57
NO POT.
NO POT.

FEB 27 '57

we pot.

MAR 13 '57

MAR 20 '57

MAR 27 '57

Ph P.

76 Bopd +

60% wtr

44° ~~40~~ gran.