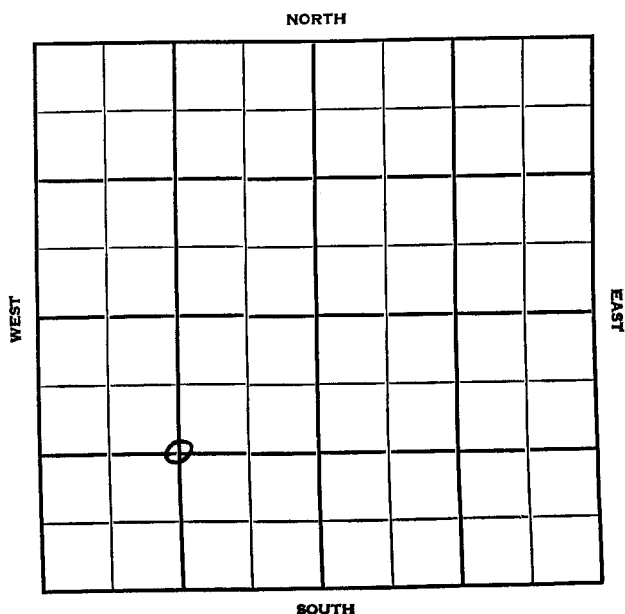


Section 2 Township 29 Range 32WWell No. 1 BrownCompany Petroleum, Inc.

Haskell KANSAS

SEC.	TWP.	R.
2	29	32W

WELL NO.

1 Brown

FARM

COMPANY

Petroleum, Inc.

CONTRACTOR

Hugoton Pool

Ft. from N. Line


1320

Ft. from S. Line

Ft. from E. Line

1320

Ft. from W. Line

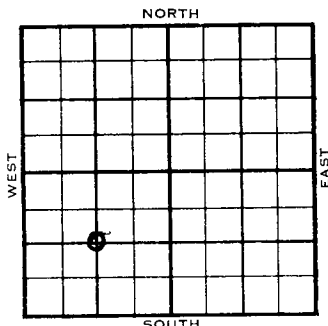

C SW/4
CSO FO

	ELEVATION	REPORT
1954	2904'	

11/10

Spud 11-6-54
8" @ 514'
rlg. 2430'

1955
1/5

Spud 11-6-54 Gas well TD 2736
8" @ 514' Her. 2643 Win. 2711
TD 2717' 5" @ 2716 DD 2736
frac. 1,200,000 CFG 500 A
1000 A 1,450,000 CFG CO to 2736
1000 A 1,100,000 CFG 2000 A
Comp. 4,500,000 CFOPD

COMPLETED


County **Haskell** State **Kansas**Sec. **2** (Blk.) **29** (Sur.) **32W** Map No.Operator **Petroleum Inc.**Well No. **1** Farm **Brown**Elev. Location **C SW/4**

1320 Ft. From **S** Line **SW****1320** Ft. From **W** Line Quarter1st. Report **NOV 10 1954**

Completion

Remarks **CSO farmout**Spudding Date **11-6-54**Drlg. Data **Hugoton Pool****8" @ 514 drlg. 2430**

County Haskell State Kansas
 Sec. 2 (Blk.) 29 (Sur.) 3 2W Map No.
 Operator Petroleum Inc.
 Well No. 1 Farm Brown
 Elev. 2904 Location C SW/4

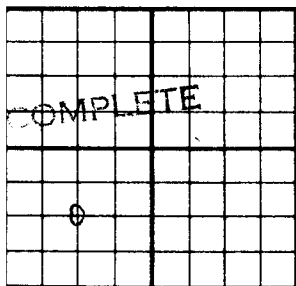

1320 Ft. From S Line SW

1320 Ft. From W Line Quarter

1st. Report

Completion JAN 5 1955

Remarks Hugoton Pool

Spudding Date 11-6-54

Drilg. Data Gas well TD 2736
8" @ 514 Her. 2643 Win. 2711 TD 2717
5" @ 2716 DD 2736 frac 1,000,000 cfg
SP 2703 210/ 2650-85 frac 1,200,000cf
500 A 1000 A 1,450,000 cfg CO to
2736 1000 A 1,100,000 cfg 2000 A
Comp. 4,500,000 cfgpd