

Form 51-5M-3-35-Mid-West

Map No. KANSAS Sec. 2 Twp. 29 R. 36-W
Well No. 1-Hastings Farm _____
Piney O & G Company _____

NORTH

WEST

EAST

SOUTH

Location _____
Drilling Remarks _____

Rig Up_____

Drilling Remarks

RECORD

Cased _____ in. _____ ft.
 Sand _____
 Gas _____
 Oil _____
 Total Depth _____

PRODUCTION

1st 24 hrs. Nat. _____
1st 24 hrs. after shot _____
Gas _____ cu. ft. _____
Dry Hole _____
Abandoned _____

Map No. KANSAS Sec. 2 Twp. 29 R. 36^W
Well No. 1- Hastings Farm
Piney 0009 Company


Ft. from N. Line

1320 Ft. from S. Line

Ft. from E. Line

1320 Ft. from W. Line

Elev. 3045 ft

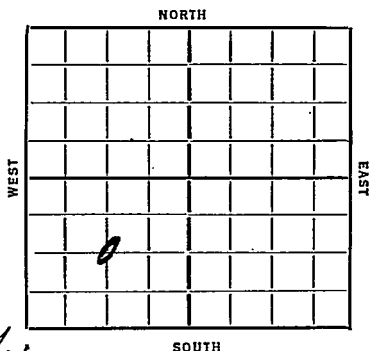

REPORT

1926
3/4 Moving Rotary
3/13 Material on ground.
3/20 --
3/27 12"-500' Drlg. plug.
4/2 --
4/10 Drlg. 1820'
4/16 8" @ 2300' RUST.
4/23 Drlg. 2585'
4/30 2840'. 3 $\frac{1}{2}$ M Gas.

5/6/36- Sand 2840-70'
T.D. 2870'
Shot 40 qts.
9 M. Gas.

COMPLETED

Map No. *10M300* Sec. *2* Twp. *29* R. *36W*Well No. *1 - Hastings**Finney O & B* Company

Contractor

FIRST REPORTS


Ft. from N. Line

1320 Ft. from S. Line

Ft. from E. Line

1320 Ft. from W. Line

SECTION PLAT

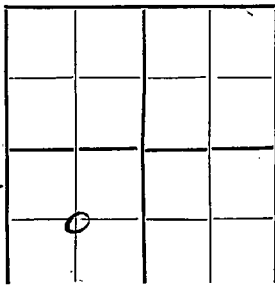

Location

Rig up

Drilling and Remarks:

Moving Rotary

RECORD

Cased _____ in., _____ ft.

Sand _____

Gas _____

Oil _____

Total Depth _____

PRODUCTION

1st 24 hrs. Nat. _____

1st 24 hrs. after shot _____

Gas _____ Cu. Ft.

Dry Hole _____

Abandoned _____

Date

3-4-36

192


ORVAL MANNSCHRECK

Scout

Map No. 1043p Sec. 2 Twp. 29 R. 36 WWell No. 1 HastingsPercy O. G. Company

Contractor

SECTION PLAT

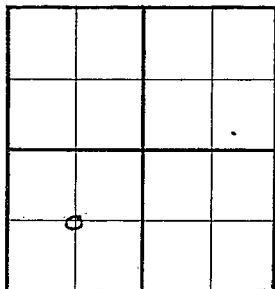

_____ Ft. from N. Line

1820 Ft. from S. Line

_____ Ft. from E. Line

1820 Ft. from W. Line

COMPLETED

Location _____

Rig up _____

Drilling and Remarks:

Sand 2840-70
shot 4896 ft.
9 M Gas.

RECORD

Cased _____ in., _____ ft.

Sand _____

Gas _____

Oil _____

Total Depth 2820

PRODUCTION

1st 24 hrs. Nat. _____

1st 24 hrs. after shot _____

Gas _____ Cu. Ft.

Dry Hole _____

Abandoned _____

Date

MAY 6 1936 19

S. J. LEWIS

Scout