


Kingham

Section 2 Township 29 Range 8-W

Well No. #1 Walton Sample

Company Stanolind

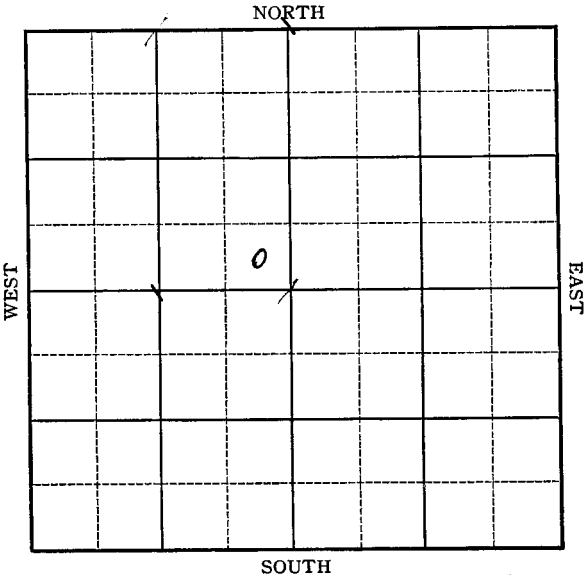

Kingman

Sec. 2 Twp. 29 R. 8-W

Well No. #1 Walton Sample Farm

Stanolind Company


Wildcat

 Ft. from N. Line

330 Ft. from S. Line

330 Ft. from E. Line

 Ft. from W. Line

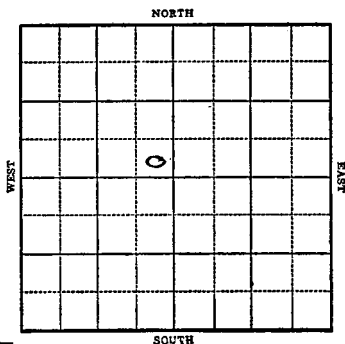

Elev. 1665

1943

R E P O R T

6/30 Location.
7/7 10" @ 314
Drlg. 1430'
7/15 Drlg. 2455'
7/21 Bse Florence 1720
Howard 2745
Topeka 2865
Douglas 3265
Lans 3440
Drlg. 3725'
7/28 Miss 4163'
Drlg. 4276'
8/4 King 4360
Viole 4500
Camp 4624
Arb 4634
Drlg. 4641'
8/11 Arb 4634
T.D. 4709'

4520
1665
28-6


ABANDONED

KANSAS**Kingman**Map No. 26 Sec. 2 Twp. 29 R. 8WWell No. 1 Walton SampleStanolind

Company

FIRST REPORT

Contractor

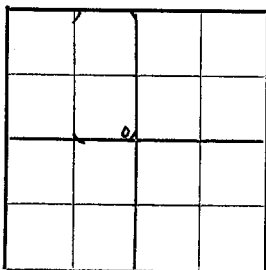SE NW**SECTION PLAT**

Ft. from N. Line

330

Ft. from S. Line

330

Ft. from E. Line

Ft. from W. Line

WALDCATLocation **XXX**

Rig up

Drilling and Remarks:

RECORD

Cased _____ in., _____ ft.

Sand _____

Gas _____

Oil _____

Total Depth _____

PRODUCTION

1st 24 hrs. Nat. _____

1st 24 hrs. after shot _____

Gas _____ Cu. Ft.

Dry Hole _____

Abandoned _____

Date

JUN 30 1943

19

S. J. LEWIS

Scout

Kingman

Map No. 36 Sec. 2 Twp. 29 R. 8WWell No. 1 Walton Sample

Stanolind


Company

ABANDONED

Contractor

SE NW

SECTION PLAT

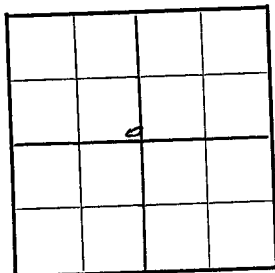

Ft. from N. Line

330 Ft. from S. Line330 Ft. from E. Line

Ft. from W. Line

WILDCAT

Location

Rig up

Drilling and Remarks:

Cr 4634

RECORD

Cased _____ in., _____ ft.

Sand _____

Gas _____

Oil _____

Total Depth 4709

PRODUCTION

1st 24 hrs. Nat. _____

1st 24 hrs. after shot _____

Gas _____ Cu. Ft.

Dry Hole _____

Abandoned _____

Date

AUG 11 1943

19

S. J. LEWIS

Scout