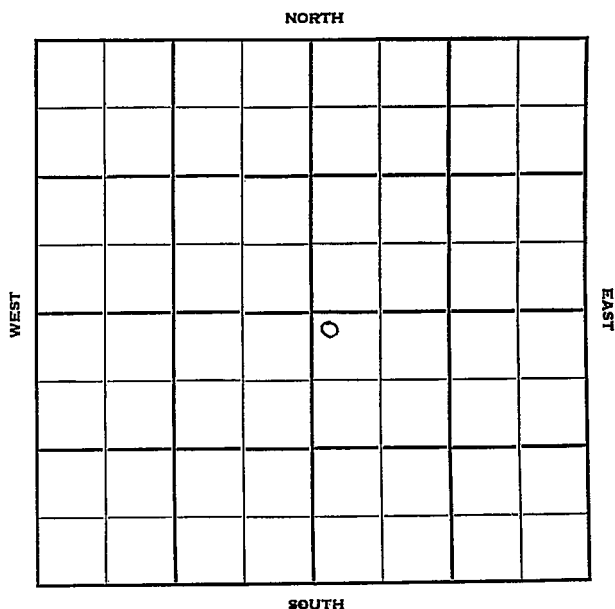


Section 2 Township 29 Range 33Well No. #1 ElliottCompany National Association Pet.

Sec. 2 Twp. 29 R. 33 ✓Well No. #1 Elliott FarmNational Association Pet. Company

Contractor


150 Ft. from N. Line

Ft. from S. Line

Ft. from E. Line

150 Ft. from W. Line

NW SE

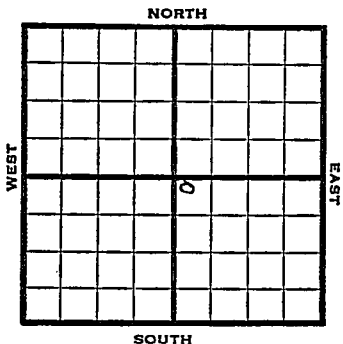

1951

Elev. 2958' REPORT

10/31

Spud 10-27-51

8" @ 630'

Drlg. 2514'

2/6

TD 2730 5" @ 2728

2/13

NR

2/20

DP 2715 144/2682-2706

90/2660-75 1000 A

DD 2748 No Inc. 4000 A

3/5

4000 A

3/12

1,950,000 gas

3/19

No report

4/2

Spud 10-27-51

Gas Well TD 2730

8" @ 630' 5" @ 2728

TD 2730 DP to 2715 144/2682-2706

90/ 2660-75 1000 A DD 2748

no inc. 4000 A Her. 2660-75

Kri. 2682-2706 12000 A

Comp. 7,043,000 gas


**COMPLETED**

County Haskell State Kansas  
 Sec. 2 (Blk.) 29 (Sur.) 33 Map No.

Operator National Association Pet.

Well No. 1 Farm Elliott

Elev. Location NW SE

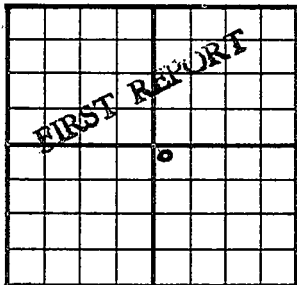

150 Ft. From N Line SE

150 Ft. From W Line Quarter

1st. Report OCT 31 1951

Completion

Remarks

Spudding Date 10-27-51

Drlg. Data

8" @ 630 Drlg. 2514

J. E. TYRA

