




Sec. 2 Twp. 29 R. 34-W

Well No. #1 Onions Farm

Cities Service et al Company

\_\_\_\_\_ Ft. from N. Line  
100 Ft. from S. Line  
100 Ft. from E. Line  
 \_\_\_\_\_ Ft. from W. Line  
 SE NW

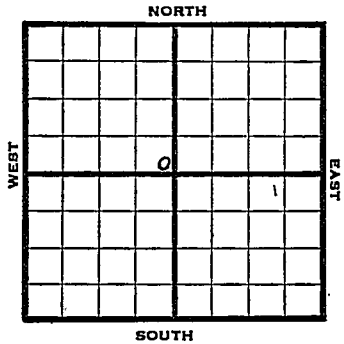

1945 Elev. 2923 REPORT

9/19 Drlg. 110'

9/26 8" @ 687  
 Drlg. 2445  
 10/3 TD 2765  
 5" @ 2764 RUST  
 10/10 " " "  
 10/17 " " "  
 10/24 15000 acid.  
 10/31 " "  
 11/7 " "  
 11/14 " "  
 11/21 " "  
 11/28 5" @ 2764  
 Perf. 15,000 acid.  
 TD 2765  
 9,240,000 Gas.  
 416# R Pr.

**COMPLETED**

Kansas Pool Name Hugoton

Map No. 2 Sec. 2 Twp. 29 R. 34W

Well No. 1 Onions

Cities Service etal Company

IRST REPO Contractor

SE NW

**SECTION PLAT**

         Ft. from N. Line

100 Ft. from S. Line

100 Ft. from E. Line

         Ft. from W. Line


Haskell County

Location                         

Rig up                         

Drilling and Remarks:  
110'

**RECORD**

Cased          in.,          ft.

Sand                         

Gas                         

Oil                         

Total Depth                         

**PRODUCTION**

1st 24 hrs. Nat.                         

1st 24 hrs. after shot                         

Gas                          Cu. Ft.

Dry Hole                         

Abandoned                         

Date

SEP 19 1945

S. J. LEWIS Scout

KANSAS

Pool Name Hugoton

Map No. W 34 W Sec. 8 Twp. 29 R. 34 W

Well No. 1 Onions

Cities Service etal Company

**COMPLETED**

Contractor

EJ, 2928

SE NW

SECTION PLAT

\_\_\_\_\_ Ft. from N. Line

100 Ft. from S. Line

10 Ft. from E. Line

\_\_\_\_\_ Ft. from W. Line

		4	

Haskell County

Location \_\_\_\_\_

Rig up \_\_\_\_\_

Drilling and Remarks:

5702264

Perf.  
15000 acid

9,240,000 lbs

416 # RPE

**RECORD**

Cased \_\_\_\_\_ in., \_\_\_\_\_ ft.

Sand \_\_\_\_\_

Gas \_\_\_\_\_

Oil \_\_\_\_\_

Total Depth 2765

**PRODUCTION**

1st 24 hrs. Nat. \_\_\_\_\_

1st 24 hrs. after shot \_\_\_\_\_

Gas \_\_\_\_\_ Cu. Ft.

Dry Hole \_\_\_\_\_

Abandoned \_\_\_\_\_

Date

NOV 28 1945

S. J. LEWIS

Scout