


Section 20 Township 29 Range 32W

Well No. #1 Kelman

Company Kansas-Nebraska Natural Gas

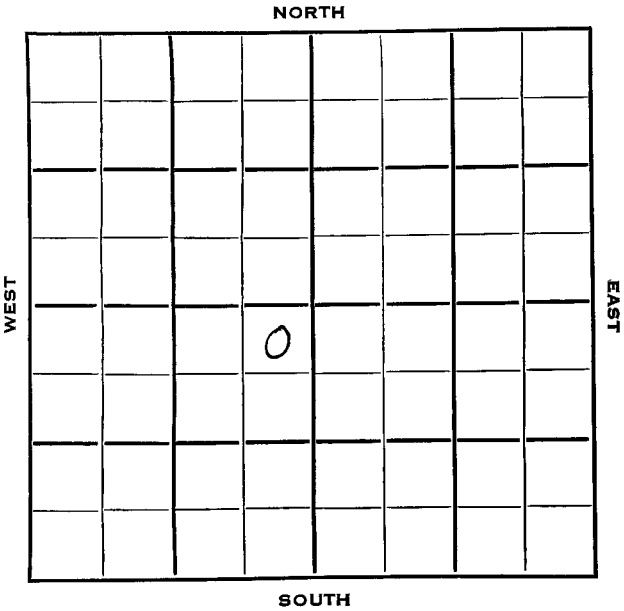

Haskell

KANSAS

SEC.	TWP.	R.
20	29	32 W

WELL NO.

1 Kelman

FARM

COMPANY

Kansas Nebraska Natural Gas.

CONTRACTOR

Hugoton Pool


150 _____ Ft. from N. Line

_____ Ft. from S. Line

150 _____ Ft. from E. Line

_____ Ft. from W. Line

NE NE SW

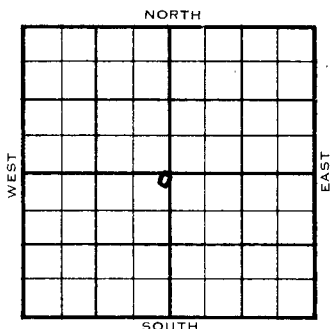

1953

ELEVATION

2917'

REPORT

12/9

Location

12/16

10" @ 598' w/100 sks
Drlg 2572'

1954

1/20

Spud 12-9-53

Gas Well

TD 2730'

10-3/4" @ 598'

Her. 2645', Kri 2667', Win 2720'

* 7" @ 2721'

CO to 2730', 1000A

PB 2700

132/2670-92, 1000A SSG 2000A

438,000 gas, frac, 3000A

CO to 2730, 12000A wtr.

PB 2724 wtr, PB 2704

Comp. 4 1/2 mcf/gpd

COMPLETED

County Haskell State Kansas

Sec. 20 (Blk. Twp.) 29 (Sur. Rge.) 32W Map No.

Operator Kansas-Nebraska Natural Gas

Well No. **1** Farm **Kelman**

Elev.	Location	NE	NE	SW
-------	----------	----	----	----

A 10x10 grid. The top row contains the text "FIRST REPORT". In the middle row, there is a small circle in the third column from the left.

150 Ft. From N Line SW

150 Ft. From E Line Quarter

1st. Report DEC 8 1953

Completion

Remarks

Spudding Date

Drig. Data Hugoton Pool

Location

J. E. McGEHEE


Sec. 20 (Blk.) 29 (Sur.) 32W Map No.

Operator Kansas Natural Gas

Well No. 1 Farm Kelman

Elev.	2017	Location	NE	FW	SW
-------	------	----------	----	----	----

COMPLETE

0

150 Ft. From ^W Line SW

150 Ft. From E Line Quarter

1st. Report

Completion JAN 20 1954

Remarks	Hugoten Pool
---------	--------------

Spudding Date 12-9-53

Orig. Data Gas well TD 2730

10 3/4" C 598 Her. 2645 Fri. 2667

Pin. 2720 7" @ 2721 00 to 2730

1000 A PE 2700 132/ 2670-92 1000 A

SSG 2000 A 438,000 cas frac

3000 A CO to 2730 12000 A wtr.

PE 3724 wtr. PE 3704

Comp. 4¹ mc f/gpd

J. G. McGEHEE