


KANSAS

DX 78-1 Kiowa

Section 21 Township 29 Range 18W

Well No. #1 Thorn

Company Gulf Oil et al

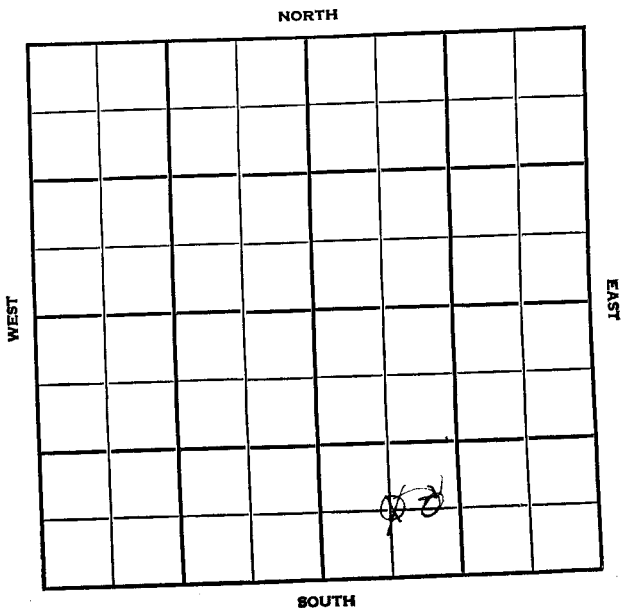

Kiowa

5

SEC. 21	TWP. 29	R. 18W
------------	------------	-----------

WELL NO. #1 Thorn FARM

COMPANY Gulf Oil, etal

CONTRACTOR Falcon-Seaboard

Nichols


_____ FT. FROM N. LINE

_____ FT. FROM S. LINE

_____ FT. FROM E. LINE

_____ FT. FROM W. LINE

C E/2
~~G~~ SW SE

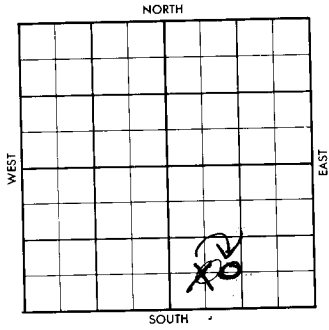

1956	ELEVATION	REPORT
------	-----------	--------

7-3 Location

COMPLETED

25

County **Iowa** Elev. _____
 Sec. **21** Twp. **29** Rge. **18W**
 Company **Gulf Oil, etal**
 Farm Name **Thorn** No. **1**

TOPS	DEPTH	LOG	DATUM
Anh.			
TP.			
H.			
Tr.			
Dg.			
Bl.			
L.			
K.C.			
B.K.C.			
Ce.			
C.			
M.			
M.			
K.			
Mz.			
Ma.			
V.			
S.			
S.			
A.			
R.			
PE.			
G.			
TD.			

Loc in Sec. **G SW SE**

Geol. _____
Contr. **Falcon-Seaboard**

Pool **Nichols**

FIRST REPORT			
		JUL 3 '56	
		o	

Date Comm. _____
Location _____

2001 1 1 100

0.8

Co.
No.
Sec.
T.
R.

CORRECTION

FORM 513 SUNRAY

County IOWA

Elev. 241

Sec. 21

Twp. 29

Rge. 18W

Company Gulf Oil, etal

Farm Name Thorn

No. 1

TOPS	DEPTH	LOG	DATUM	Loc. in Sec.
Ans.				9 SW 30 CE/2
Tr.				
Dg.	4180			
Bl.	4320			
L.	4334			
K.C.				
B.K.C.				
Ge.				
C.				
M. <u>chert</u>	4937			
M.				Falcon-Seaboard
K.				Pool
Mz.				Nichols
Me.				<div style="border: 1px solid black; padding: 5px; display: inline-block;"> <p>COMPLETE</p> <p>SEP 12 '56</p> <p><i>[Signature]</i></p> </div>
V.				
S.				
S.				
A.				
R.				
PC.				
G.				
TD	5095			

Date Comm.

Location JUL 11 '56 JUL 18 '56 JUL 25 '56

7-22-56 11 912 AUG 1 '56

8 376/250 11 3460

AUG 8 '56 DST 4333-61 1m 9/8"

92 60 MCF/15" net 124'

GCWM BHP 1135/30 11 4597

AUG 15 '56 DST 4975-96 or 20"

6/2 1/2" oil in 13" est 15 to 20

Bohr 922 est 1 Mill-CEG

CP 1150# AUG 22 '56 AUG 29 '56 SEP 5 '56
SEP 12 '56

TS+ 4,200 MCFG.
OP FLOW 2,400 MCFG PD
CP 1400 TP 1200