


Kiowa

KANSAS

SECTION 21 TOWNSHIP 29 RANGE 18W

WELL NO. #1 Jansen

COMPANY Gulf Oil Corp.

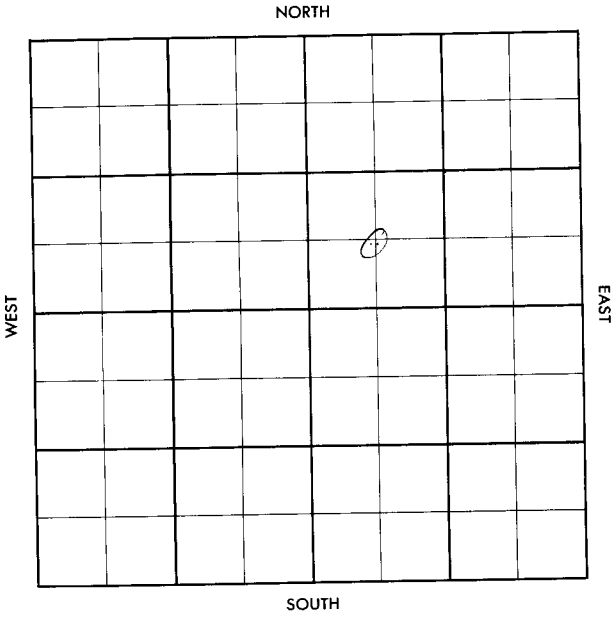

County Kiowa Elev. _____
 Sec. 21 Twp. 29S Rge. 18W
 Company Gulf Oil Corp.
 Farm Name Jansen No. 1

TOPS	DEPTH	LOG	DATUM	Loc. in Sec.																										
Anh.				C SW NE																										
Tr.																														
H.																														
Tr.																														
Dg.																														
Bl.																														
L.				Geol. _____																										
K.C.				Contr. _____																										
B.K.C.																														
Ce.																														
C.																														
M.				Pool																										
M.				Nichols																										
K.				<table border="1"> <tr> <td colspan="3" rowspan="2">FIRST REPORT</td> </tr> <tr> <td></td> </tr> <tr> <td></td> <td></td> <td></td> </tr> <tr> <td></td> <td></td> <td></td> </tr> <tr> <td></td> <td></td> <td></td> </tr> <tr> <td></td> <td></td> <td></td> </tr> <tr> <td></td> <td></td> <td></td> </tr> <tr> <td></td> <td></td> <td></td> </tr> <tr> <td></td> <td></td> <td></td> <td>OCT 3 '56</td> </tr> </table>	FIRST REPORT																									OCT 3 '56
FIRST REPORT																														
			OCT 3 '56																											
Mz.																														
Me.																														
V.																														
S.																														
S.																														
A.																														
R.																														
Pe.																														
G.																														
TD																														

Date Comm. _____

Log.

Co.

Loc.

No.

Sec.

T.

R.

~~25~~

County Knowlton Elev. 2220
 Sec. 21 Twp. 29S Rgn. 18W
 Company Gulf Oil Corp.
 Farm Name Jansen No. 1

	TOPS	DEPTH	LOG	DATUM
Anh				
Tp				
M		4125	4125	
Tr				
Dp		4163	4160	
Bl			4303	
L		4312	4314	
Kc				
Rkc				
Cc				
C				
M	chert	4912	4918	
M	li	4962	4962	
K				
Mz				
Ms				
V				
S				
S				
A				
R				
PE				
G				
TD		5025		

Loc in Sec. C SW NE

Geol. _____
 Conts. _____
 Pool _____
Nichols

OCT 31 '56	

ABANDONED

Date Comm. _____
 LOC OCT 10 '56 OCT 17 '56 10-11-56

578 397 / 225 ID 2872
OCT 24 '56 ID 4515 OCT 31 '56 DST 4950-62
one lhr. 90' SOCM BHP. 555/30"
DST 4912-62 one lhr 6 1/2" ga
887 MGF net. 180' GCM BHP
1545/30" DST 4958-85 lhr 30'
Md FR 0 BHP 45/30"
Temp Abd.