


DX 78-1 Kiowa

KANSAS

Section 21 Township 29S Range 18W

Well No. #2 J. P. Unruh "B"

Company Gulf Oil Corp

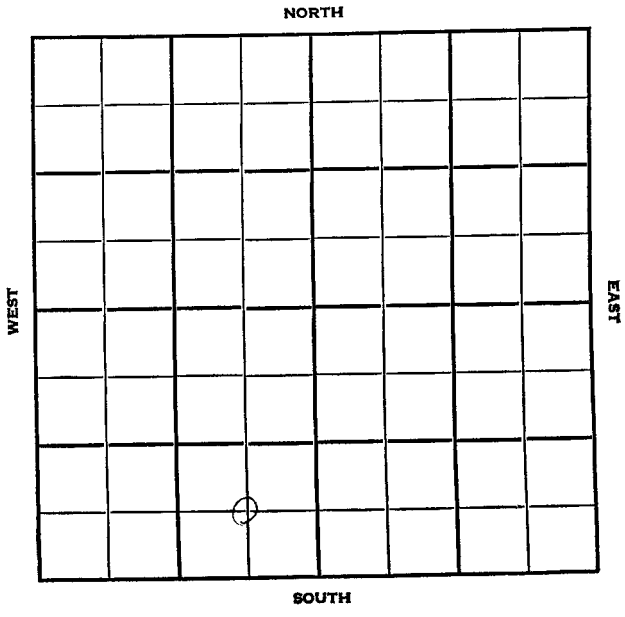

Kiowa

KANSAS

SEC. 21	TWP. 29	R. 18W
------------	------------	-----------


WELL NO. #2 J.P. Unruh "B" FARM

COMPANY Gulf Oil Corp.

CONTRACTOR

Nichols

_____ FT. FROM N. LINE
 _____ FT. FROM S. LINE
 _____ FT. FROM E. LINE
 _____ FT. FROM W. LINE

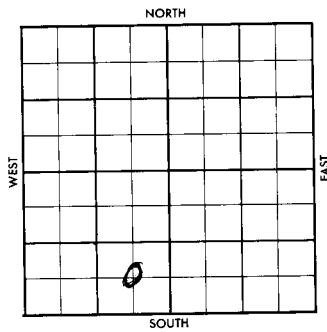

C SE SW

1956	ELEVATION	REPORT
------	-----------	--------

8-29 Location

FORM 513 SUNRAY

County Kiowa Elev. _____
 Sec. 21 Twp. 29S Rge. 18W
 Company Gulf Oil Corp.
 Form Name J. P. Unruh "B" No. 2

TOPS	DEPTH	LOG	DATUM	Loc. in Sec.
Ans.				C SE SW
Tr.				
H.	4148	4145		
Tr.				
Dg.	4179	4178		
Bl.	4318	4318		
L.	4330	4330		
K.C.				Geol. _____
B.K.C. <u> Mard </u>		4758		Contr. _____
Ce.				
C.				
M. <u> chert </u>	4945	4945		
M. <u> L1 </u>		5054		Pool _____
K.				
Mz.				<u> Nahols </u>
Me.				
V.				
S.				
S.				
A.				COMPLET
R.				
PC.				NOV 15 '56
G.				
TD	5102			

Date Comm.

LOG SEP 5 '56 8-31-56 85/8 39
 1250 M 2400 SEP 12 '56 M 4296
 SEP 19 '56 CID 4981-5000 net 17'
 DST 4960-99 50" @ 1/2" ga
 310 MCF Md/40" oil/42" es
 10 Boph BHP 1610/30"
 Rng Lag SEP 26 '56 5 1/2 @ 5101/11
 PB 5079 24/4984-90 1/2 Flu
 18 Boph 670 wt 3 hr ga ga

800 NCF Flw 98 B0 +
6 to wtr, @ 2 3/4" ch.

OCT 3 '56 OCT 10 '56 OCT 17 '56 ✓ OCT 24 '56

OCT 31 '56 NOV 7 '56 NOV 13 '56

B4 Bomb Flow 868 B0 +
36 BW gran 32°

County Kiowa Elev. _____
 Sec. 21 Twp. 29S Rge. 18W
 Company Gulf Oil Corp.
 Farm Name J. P. Unruh #B No. 2

TOPS	DEPTH	LOG	DATUM	Loc. in Sec.
				C SE SW
Anh.				
Tr.				
H.				
Tr.				
Dg.				
Bl.				Geol.
L.				Contr.
K.C.				
B.K.C.				
Ce.				
C.				
M.				Pool
M.				Nichols
K.				
Mz.				
Me.				
V.				
S.				
S.				
A.				
R.				
Pe.				
G.				
TD				

FIRST REPORT
 AUG 29 1956
 0

Date Comm. _____
 Loc. _____

