


Section 21 Township 29 Range 37 W

Well No. # 1 Campbell

Company Hugoton Prod.

NORTH

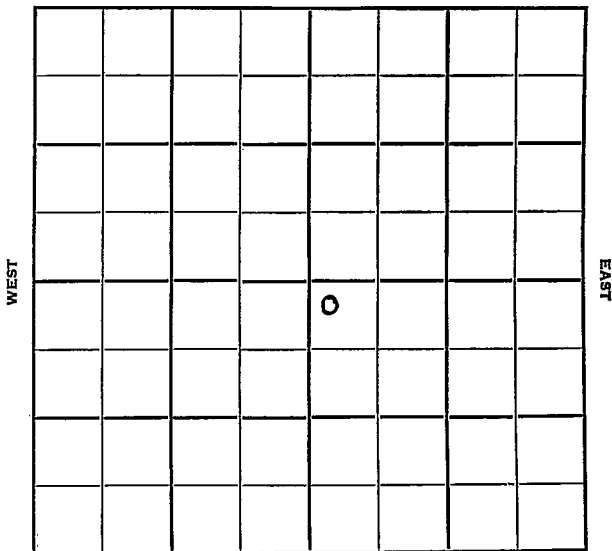

SOUTH

Grant

KANSAS

Sec. 21 Twp. 29 R. 37 W

Well No. # 1 Campbell Farm

Hugoton Prod. Company

Contractor

Hugoton Pool


200 Ft. from N. Line

Ft. from S. Line

Ft. from E. Line

200 Ft. from W. Line

NW SE

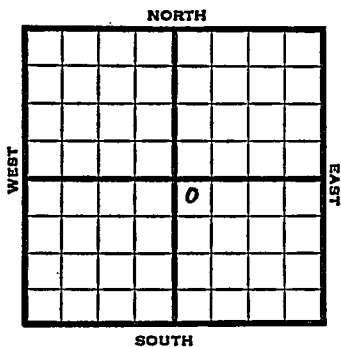

1951

Elev. 3067' REPORT

12/12

Location

1952

2/6

Spud 12-16-51

Gas Well TD 2617

10" @ 560 7" @ 2387

TD 2617 Her. 2388

Kri 2408 Win 2470

Ft. Riley 2524 9000 A

Comp. 38,447,000 gas

COMPLETED

