


Section 21 Township 29 Range 32W

Well No. 2 L. C. Leonard

Company Kansas Natural Gas

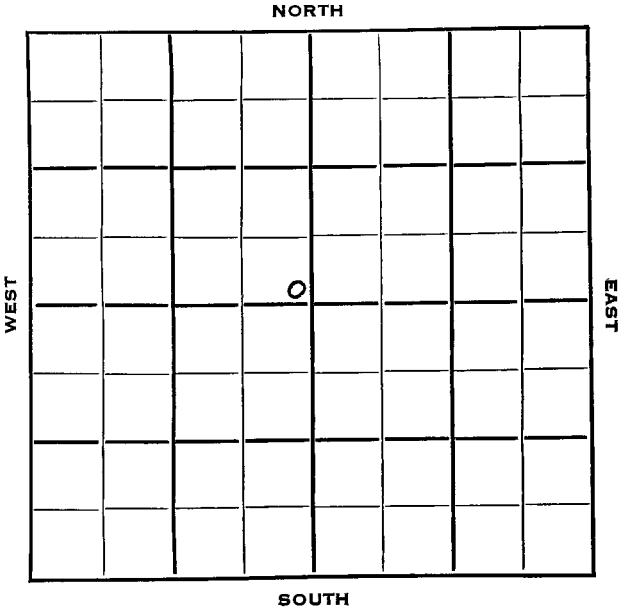

Haskell

KANSAS

SEC.

TWP.

R.

21

29

32 W

WELL NO.

2 L. C. Leonard

FARM

COMPANY

Kansas Natural Gas

CONTRACTOR

Hugotn Pool

Ft. from N. Line

150


Ft. from S. Line

150

Ft. from E. Line

Ft. from W. Line

SE SE NW

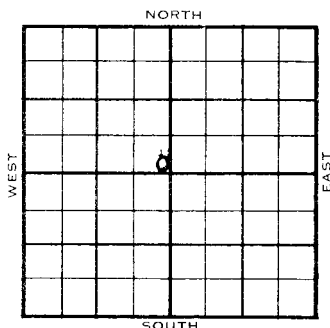

ELEVATION

REPORT

1953

2914'

12/16

Location

1954

2/10

Spud 12-16-53

Gas Well

TD 2743'

10" @ 559'

Her 2654', Kri 2672', Win 2722'

TD 2722'

7" @ 2721'

DD 2743', 6000A, PB 2710

24/2658-62', 152/2680-2706, 13000A
2000A

Comp. 12,865,000 gas

COMPLETED

County **Haskell** State **Kansas**

Sec. **21** (Blk. **29** (Sur. **32W** Map No.

Operator **Kansas Natural Gas**

Well No. **2** Farm **L. C. Leonard**

Elev.	Location	SE	SE	NW
-------	----------	----	----	----

0

FIRST REPORT

150 Ft. From S Line NEW

150 Ft. From **E** Line Quarter

1st. Report

Completion

Remarks

Spudding Date

Orig. Data Hugoton Pool

Location

J. G. McGEHEE

J. G. McGUIRE