


Map No. Kansas Sec. 21 Twp. 29 R. 9W.Well No. 1 N. Gillens Farm
Phillips Pet. Company

NORTH

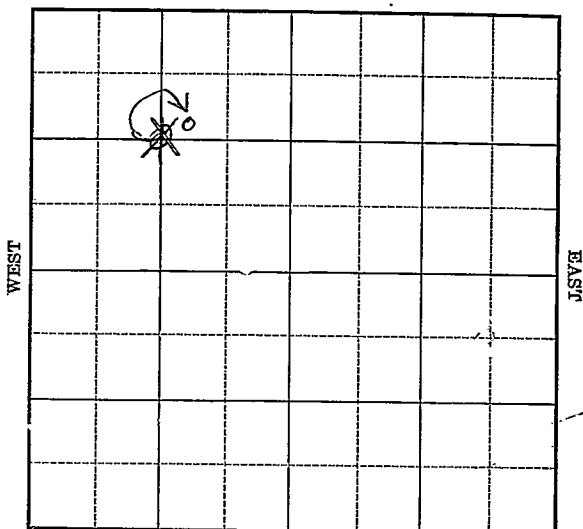

SOUTH

Location _____

Drilling Remarks _____

Rig Up _____

Drilling Remarks _____

RECORD

Cased _____ in. _____ ft.

Sand _____

Gas _____

Oil _____

Total Depth _____

PRODUCTION

1st 24 hrs. Nat. _____

1st 24 hrs. after shot _____

Gas _____ cu. ft.


Dry Hole _____

Abandoned _____

Kingman

Map No. Kansas Sec. 21 Twp. 29 R 9^wWell No. 1 N. Gullene FarmPhillips Pet Company

NORTH

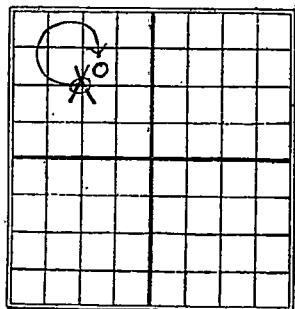

WEST

EAST

SOUTH

990

~~1320~~ Ft. from N. Line

Ft. from S. Line

990

Ft. from E. Line

~~1320~~

Ft. from W. Line

Date

REPORT

1926

3/9 Location

4/14

4/21

4/29 Log

5/26 T.D. 1040 drilling by tools

6/2

6/9 Only 1235'

6/16 " 1380'

6/23 " 2150'

6/30 T.D. 2150' U.P. 10"

7/14 Dlg 2600

7/21 " 3000'

7/28 " 3040

8/4 " 3285

8/11 repairing rig T.D. 3285

8/18 Dlg 3370

8/25 " 3440

9/1 " 3510

9/8 " 3610

9/15 T.D. - 3662' U.P.

9/22 Only 3740

9/29 " 3850

- 10/6 - J.D. 3880 - U.R. 6"
- 10/13 - _____
- 10/20 - Duly 3910
- 10/27 - " 4075
- 11/3 - " 4115
- 11/10 - " 4135
- 11/17 - J.D. 4108 - S.L.M.
running 4"
- 11/24 - Top Chat 4184 show gas 4190 showed
J.D. 4195 S.D. for U.R.
- 12/1 - J.D. 4195 fishing
underreamer
- 12/8 - Pulling 4" fishing U.R.
- 12/15 - T.D. 4195' Str. Ream
- 12/21 - same
- 12/29 - _____
- 1927
- 1/5 - Abandoned 4207

Map No. KANSAS Sec. 21 Twp. 29 R. 9 N

Well No. 1 N. Gillens

Phillips P & S Company

Contractor

SECTION PLAT

290 Ft. from N. Line

_____ Ft. from S. Line

990 Ft. from E. Line

0 Ft. from W. Line

	0		

Correction

Location _____

Rig up _____

Drilling and Remarks:

*I reported
this in the center
NW 1/4 should
be 894. NE NW.*

RECORD

Cased _____ in., _____ ft.

Sand _____

Gas _____

Oil _____

Total Depth _____

PRODUCTION

1st 24 hrs. Nat. _____

1st 24 hrs. after shot _____

Gas _____ Cu. Ft.

Dry Hole _____

Abandoned _____

Date

APR 14 1920

S. J. LEWIS

Scout

Map No. 14215 Sec. 35 Twp. 30 R. 9W

Well No. 1 Keimig

Vickers & Stearns Company

Contractor


SECTION PLAT

1320 Ft. from N. Line

_____ Ft. from S. Line

_____ Ft. from E. Line

1320 Ft. from W. Line

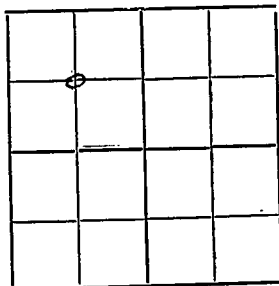

FIRST REPORTS

Location _____

Rig up _____

Drilling and Remarks:

Location

RECORD

Cased _____ in., _____ ft.

Sand _____

Gas _____

Oil _____

Total Depth _____

PRODUCTION

1st 24 hrs. Nat. _____

1st 24 hrs. after shot _____

Gas _____ Cu. Ft.

Dry Hole _____

Abandoned _____

Date

MAR 3 1926

S. J. LEWIS

Scout

Map No. **KANSAS**

Sec. 21 Twp. 29 R. 9 W


Well No. 1 V Gillens

Phillips Pet.

Company

Contractor

SECTION PLAT

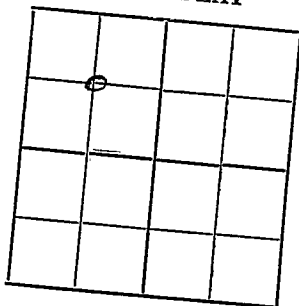

1320 Ft. from N. Line

----- Ft. from S. Line

----- Ft. from E. Line

1320 Ft. from W. Line

FIRST REPORTS

Location -----

Rig up -----

Drilling and Remarks:

Location

RECORD

Cased ----- in., ----- ft.

Sand -----

Gas -----

Oil -----

Total Depth -----

PRODUCTION

1st 24 hrs. Nat. -----

1st 24 hrs. after shot -----

Gas ----- Cu. Ft.

Dry Hole -----

Abandoned -----

Date

MAR 9

1902

S. J. LEWIS

Scout

Kingman
Hogman
 Map No. KANSAS Sec. 21 Twp. 29 R. 24

Well No. 1 Schults

Phillips P & S Company

Contractor

SECTION PLAT


1320 Ft. from N. Line

_____ Ft. from S. Line

_____ Ft. from E. Line

1320 Ft. from W. Line

ABANDONED

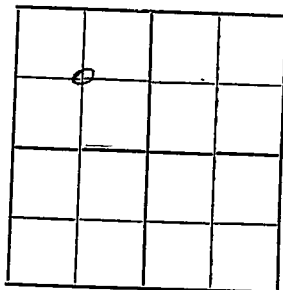

Location _____

Rig up _____

Drilling and Remarks:

T D 4207 H P W

D & A

RECORD

Cased _____ in., _____ ft.

Sand _____

Gas _____

Oil _____

Total Depth _____

PRODUCTION

1st 24 hrs. Nat. _____

1st 24 hrs. after shot _____

Gas _____ Cu. Ft.

Dry Hole _____

Abandoned _____

Date _____

JAN 5 1927

_____ 192_____

S. J. LEWIS

Scout

MAP No. _____ SEC. 21 TWP. 79 S R. 90 WWELL No. 1 DehulteCOMPANY PhillipsCONTRACTOR Woolcamp

SECTION PLAT

	0		

_____ FT. FROM N. LINE

_____ FT. FROM S. LINE

_____ FT. FROM E. LINE

_____ FT. FROM W. LINE

LOCATION _____

RIG UP _____

DRILLING AND REMARKS: 4207 ft. deep

RECORD

CASED _____ IN. _____ FT.

SAND _____

GAS _____

OIL _____

TOTAL DEPTH 4206

PRODUCTION

1ST 24 HRS. NAT. _____

1ST 24 HRS. AFTER SHOT _____

GAS _____ CU. FT.

DRY HOLE ☒ABANDONED ☒

DATE

2/11 1927

SCOUT