
Kingman

SECTION 22 TOWNSHIP 29S RANGE 10W

WELL NO. #1 Spade "E"

COMPANY Petroluem Inc.

NW NW SE

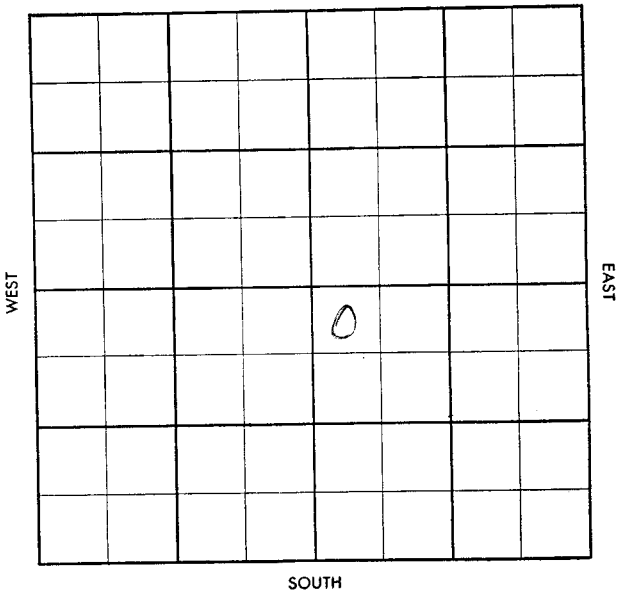

FORM 504-3 SUNRAY

K-7

S-513-A

CO. Kingman ELEV.

SEC. 22 TWP. 29 RGE. 10W

COMPANY Petroleum Inc. NO. 1

FIRST REPORT
JAN 15 '58

FARM Spade "E" Champlin - DHM

LOC. NW NW SE Sun - FO

GEOL.

CONTR Garvey Tools #5

POOL Spade Abn. Pool

SPUD 1/9/58

8" @ 253 w/175, Drlg. 2750.

CO. LSE. NO. SEC. TWP. RGE.

S-513-A

CO. Kingman ELEV 1766 KB 1764 DF

SEC. 22 TWP. 29 RGE. 10W

COMPANY Petroleum Inc. NO. 1

ABANDONED
JAN 29 '58

FARM Spade "E"

LOC. NW NW SE

Champlin - DHM
Sun - FO

H 3564
Dsh 3646
L 3733
Bkc 4150
M 4310
Mli 4356
V 4597
Ssh 4667
Ssd 4669
TD 4723

GEOL.

CONTR. Garvey Tools #5

POOL Spade Abn. Pool

SPUD 1/9/58

8" @ 253 w/185, Drlg. 2750. JAN 22 '58 ϕ 4140

JAN 29 '58 DST 4312-22 60" 60' Gip 30' M vso BHPO DST 4324-60 60" 160' M 120' SW BHP 1380/30" DST 4599-4603 60" 1560 Gip 160 Hg +50cm 1140' SW +tr oil FP 140-166 BHP 1700/20" DST 4663-75 60" 35' M FP 0 BHP 1720/30" Log tops M 4309 Mli 4354 V 4597 Ssh 4664 Ssd 4669

DSA

CO. LSE. NO. SEC. TWP. RGE.