


ANSAS Sedgwick County

Section 22 Township 29 Range 2W

Well No. #1 Hockett-Draper

Company Branine & Holl

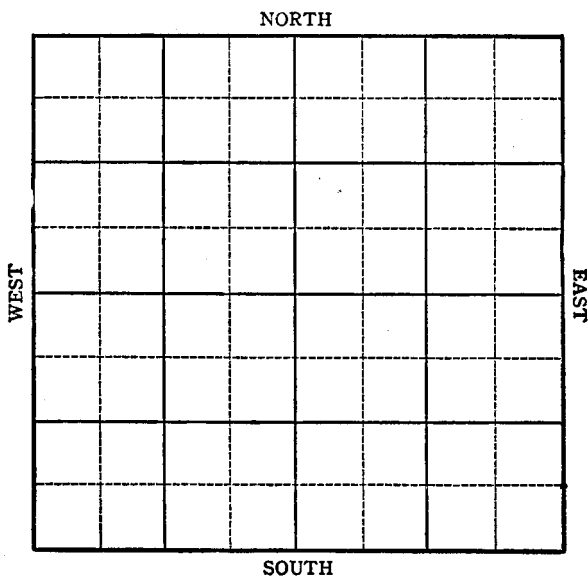

KANSAS Sedgwick County

Sec. 22 Twp. 29 R. 2W

Well No. #1 Hockett-Draper Farm

Branine & Holl Company


Wildcat

Ft. from N. Line

330 Ft. from S. Line

Ft. from E. Line

990 Ft. from W. Line

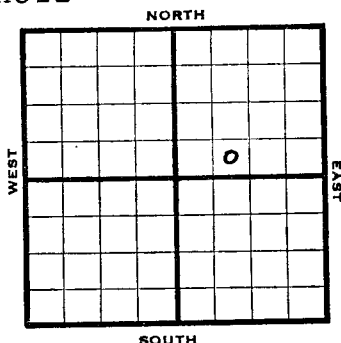

SE SW NE

R E P O R T

1944

9/27	15" - 54'				
	Drlg. 205'				
10/4	15" @ 54				
	12" @ 393				
	Drlg. 858				
10/11	10" @ 1228	CO			
10/18	Drlg. 1920				
10/25	Drlg. 2103				
11/1	Drlg. 2340				
11/8	8" @ 2285				
	6" @ 2740				
	Drlg. 2755				
11/16	KC 2932				
	Drlg. 3043				
11/24	TD 3054	6" @ 3024	SD		
11/29	"	"	"	"	"
12/6	"	"	"	"	"
12/13	KC 2932				
	6" @ 3024'				
	TD 3054'				
	1000 acid				
	Pump 130 Pot. plus Water				
	Grav. 36.0				

COMPLETED

KANSAS

Pool Name WildcatMap No. 38 Sec. 22 Twp. 29 R. 2WWell No. 1 Hockett-DraperBranine & Holl


Company

FIRST REPORT

Contractor

SE SW NE

SECTION PLAT

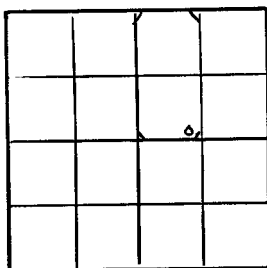 Ft. from N. Line330 Ft. from S. Line Ft. from E. Line990 Ft. from W. LineSedgwickLocation Rig up

Drilling and Remarks:

15" - 54'Dr1g 205'

RECORD

Cased in., ft.Sand Gas Oil Total Depth

PRODUCTION

1st 24 hrs. Nat. 1st 24 hrs. after shot Gas Cu. Ft.Dry Hole Abandoned

Date

SEP 27 1944

19

S. J. LEWIS

Scout

Pool Name ClearwaterMap No. 38 Sec. 22 Twp. 29 R. 2WWell No. 1 Hockett-DraperBranine & Holl Company**COMPLETED**SE SW NE Contractor**SECTION PLAT**

 Ft. from N. Line330 Ft. from S. Line Ft. from E. Line990 Ft. from W. LineSedgwickLocation Rig up

Drilling and Remarks:

KC 29326" C30241000 acidPump 130 RY
+ Water96 2/3**RECORD**Cased in., ft.Sand Gas Oil Total Depth 2954**PRODUCTION**1st 24 hrs. Nat. 1st 24 hrs. after shot Gas Cu. Ft.Dry Hole Abandoned

Date

DEC 13 1944 19S. J. LEWIS

Scout