


Section 22 Township 29 Range 32W

Well No. 1 Pennington

Company Kansas Natural Gas

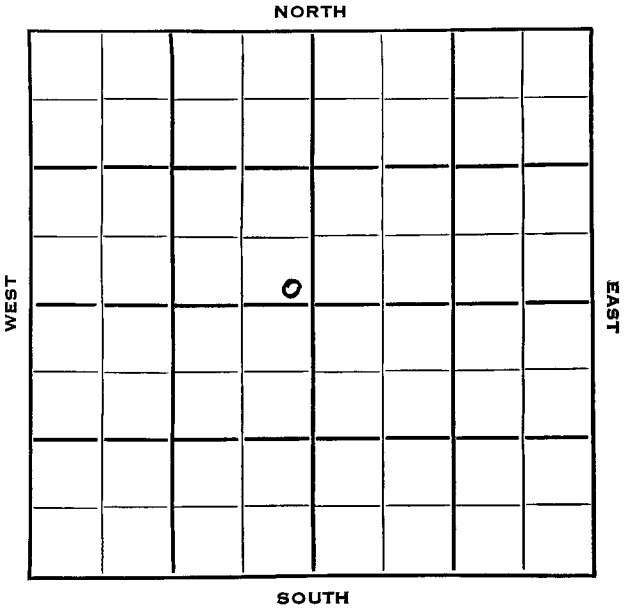

Haskell

KANSAS

SEC.	TWP.	R.
22	29	32W

WELL NO.

#1 Pennington

FARM

COMPANY

Kansas Natural Gas

CONTRACTOR

Trans-Era

Ft. from N. Line


150

Ft. from S. Line

150

Ft. from E. Line

Ft. from W. Line

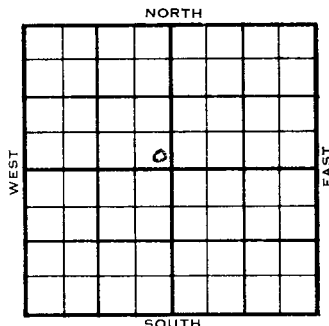

SE SE NW

Stanolind F/O

	ELEVATION	REPORT
1954	2903'	
3/17	Spud 3-11-54 10" @ 587' Drlg 2595'	
3/24	RTD 2752' Her. 2656', Kr. 2680', Win 2730' 7" @ 2751'	
3/31	WOCT.	
4/28	Spud 3-11-54 Gas well TD 2752' 10" @ 587 Her. 2656 Kri. 2680 Win. 2730 TD 2752 7" @ 2751 CO to 2742 4/2723 SP 2715 120/2684-2704 2000 A CO to 2749 48/2736-44 1000 A 291,000 CFG dol-frac. 525,000 CFG 3 BFPH 48/2660-68 24/2704-08 1500 A 411,000 CFG 2000 A frac. 876,000 gas. frac. CO to 2752 Comp. 6,750,000 gas.	
	COMPLETED	

County **Haskell** State **Kansas**

Sec. **22** (Blk. **29** (Sur. **32W** Map No.

Operator **Kansas Natural Gas**

Well No. **1** Farm **Pennington**

Elev.	Location	SE SE NW
-------	----------	-----------------

0

FIRST REPORT

150 Ft. From **S** Line **NW**

150 Ft. From **E** Line Quarter

1st. Report MAR 17 1954

Completion

Remarks	Stanolind farmout
---------	-------------------

Trans-Era - Contr.


Spudding Date **3-11-54**

Orig. Data

10" @ 587 drlg. 2595

J. G. McGEHEE

County Haskell State Kansas
 Sec. 22 (Blk.) 29 (Sur.) 3 2W Map No. _____
 Operator Kansas Natural Gas
 Well No. 1 Farm Pennington
 Elev. 2903 Location SE SE NW

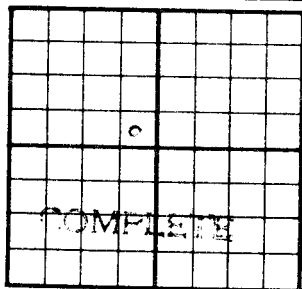

150 Ft. From S Line NW
150 Ft. From E Line Quarter
 1st. Report _____
 Completion APR 28 1954
 Remarks _____
Trans-Era - Contr.

Spudding Date 3-11-54

Drlg. Data Gas well TD 2752
10" @ 587 Her. 2656 Kri. 2680
Win. 2730 TD 2752 7" @ 2751 CO to 274
4/ 2723 SP 2715 120/ 2684-2704 2000 A
CO to 2749 48/ 2736-44 1000 A
291,000 cfg dol-frac 525,000 cfg
3 bfph 48/ 2660-68 24/ 2704-08 1500 A
411,000 cfg 2000 A frac 876,000 gas
frac CO to 2752 Comp. 6,750,000 gas