
Kingman KANSAS

SECTION 22 TOWNSHIP 29 RANGE 7W

WELL NO. #1 Woman "B"

COMPANY Cities Service

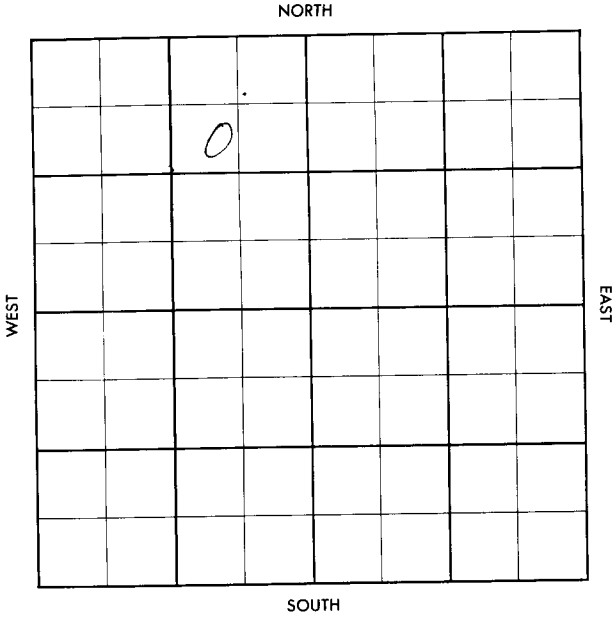

FORM 513 SUNRAY

County Kingman Elev.

Sec. 22 Twp. 29S Rge. 7W

Company Cities Service

Farm Name Bonar "B" No. 1


TOPS	DEPTH	LOG	DATUM
Anh.			
Tp.			
H.			
Tr.			
Dg.			
B.L.			
L.			
K.C.			
B.K.C.			
Ce.			
C.			
M.			
M.			
K.			
Mz.			
Mc.			
V.			
S.			
S.			
A			
R.			
Pc.			
G.			
TD			

Loc. in Sec. SW NE NW

Geol.

Contr. Barbour

Pool

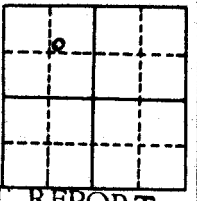

FIRST REPORT

Date Comm.

RUR OCT 10 '58

FORM 513 SUNRAY

County Kingman Elev. 1581

Sec. 22 Twp. 29S Rge. 7W

Company Cities Service

Farm Name Doran "B" No. 1

TOPS	DEPTH	LOG	DATUM
Anh.			
Tp.			
H.			
Tr.			
Dg.			
Bl.			
L.	3339		
K.F.			
B.K.C.			
Ce.			
C.			
M. 4125	~~4139~~		
M.			
K.	4400		
Mi.			
Mo.			
V.	4506		
S.	4508		
S.			
A			
R.			
Pe.			
G.			
T.D.	4515		

Loc. in Sec. SW NE NW

Geol.

Contr. Barbour

Pool

NOV 15 '56

COMPLETE

Date Comm.

RUR OCT 17 '56 10-9-56 85/8 400/45

RD 3370 OCT 24 '56 DST 4135-43 1hr ga 260 MCF in 1hr sec 35' Md BHP 1400/30" DST 4143-55 1hr ga 242 MCF sec 30' Md + 60' MW 1380/30" DST 4155-70 1hr 410 MCF in 1hr sec 65' md 1450/30" DST 4170-85 1hr 20' Md BHP

FORM 513-1 SUNRAY

790/30 D 4275 OCT 31 '55
5½ @ 4200 /150 NOV 7 '55 CO
4175 85/ 4136-51 gq 250 MCF
+ 12 Gwph 29/4126-31 gq
310 MCFG + 16 Gwph Frac
tst est 4 Mill CFG 5.1 NOV 15 '55
op Flw 2,700 MCFG
+ 4 Bswph + scum oil